


1 LOCATION OF WATER WELL: County: <u>Riley</u>	Fraction <u>SE 1/4 SW 1/4 NW 1/4</u>	Section Number <u>1</u>	Township Number <u>T 9 S</u>	Range Number <u>R 5 EW</u>
---	---	----------------------------	---------------------------------	-------------------------------

Distance and direction from nearest town or city street address of well if located within city?
413 W KANSAS RILEY KANSAS ADJACENT TO SIDEWALK MW-21A

2 WATER WELL OWNER: <u>KDHE</u>	Board of Agriculture, Division of Water Resources
RR#, St. Address, Box # : <u>FORBES FIELD</u>	Application Number:
City, State, ZIP Code : <u>TOPEKA, KANSAS 66620</u>	

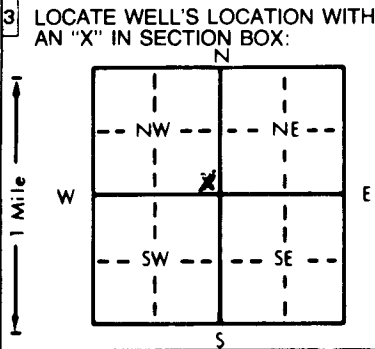

4 DEPTH OF COMPLETED WELL: 25 ft. ELEVATION: _____

Depth(s) Groundwater Encountered: 19 ft. 2. _____ ft. 3. _____ ft.

WELL'S STATIC WATER LEVEL: 19 ft. below land surface measured on mo/day/yr _____

Pump test data: Well water was _____ ft. after _____ hours pumping _____ gpm

Est. Yield _____ gpm: Well water was _____ ft. after _____ hours pumping _____ gpm

Bore Hole Diameter: 7 1/4 in. to 25 in. to _____ in. to _____ in. to _____ in. to _____ in.

WELL WATER TO BE USED AS:

5 Public water supply	8 Air conditioning	11 Injection well
1 Domestic	3 Feedlot	6 Oil field water supply
2 Irrigation	4 Industrial	7 Lawn and garden only
		10 Monitoring well
		12 Other (Specify below)

Was a chemical/bacteriological sample submitted to Department? Yes _____ No (X) If yes, mo/day/yr sample was submitted _____

Water Well Disinfected? Yes _____ No (X)

5 TYPE OF BLANK CASING USED:

1 Steel	3 RMP (SR)	6 Asbestos-Cement	9 Other (specify below)
<u>2 PVC</u>	4 ABS	7 Fiberglass	

Blank casing diameter: 2 in. to 15 ft., Dia _____ in. to _____ ft., Dia _____ in. to _____ ft.

Casing height above land surface: 0 in., weight _____ lbs./ft. Wall thickness or gauge No. Sch 40

TYPE OF SCREEN OR PERFORATION MATERIAL:

1 Steel	3 Stainless steel	5 Fiberglass	8 RMP (SR)	10 Asbestos-cement
2 Brass	4 Galvanized steel	6 Concrete tile	9 ABS	11 Other (specify)
				12 None used (open hole)

SCREEN OR PERFORATION OPENINGS ARE:

1 Continuous slot	<u>3 Mill slot</u>	5 Gauzed wrapped	8 Saw cut	11 None (open hole)
2 Louvered shutter	4 Key punched	6 Wire wrapped	9 Drilled holes	
		7 Torch cut	10 Other (specify)	

SCREEN-PERFORATED INTERVALS: From 25 ft. to 15 ft., From _____ ft. to _____ ft.

GRAVEL PACK INTERVALS: From 25 ft. to 13 ft., From _____ ft. to _____ ft.

6 GROUT MATERIAL:

1 Neat cement	<u>2 Cement grout</u>	<u>3 Bentonite</u>	4 Other
---------------	-----------------------	--------------------	---------

Grout Intervals: 3 From 13 ft. to 11 ft. 2 From 11 ft. to 0 ft., From _____ ft. to _____ ft.

What is the nearest source of possible contamination:

1 Septic tank	4 Lateral lines	7 Pit privy	<u>10 Livestock pens</u>	14 Abandoned water well
2 Sewer lines	5 Cess pool	8 Sewage lagoon	<u>11 Fuel storage</u>	15 Oil well/Gas well
3 Watertight sewer lines	6 Seepage pit	9 Feedyard	12 Fertilizer storage	16 Other (specify below)
			13 Insecticide storage	

Direction from well? West How many feet? 400

FROM	TO	LITHOLOGIC LOG	FROM	TO	PLUGGING INTERVALS
<u>0</u>	<u>1.5</u>	<u>Top Soil</u>			
<u>1.5</u>	<u>8</u>	<u>Silty Clay</u>			
<u>8</u>	<u>10.5</u>	<u>Interbedded limestone + shale</u>			
<u>10.5</u>	<u>25</u>	<u>limy shale</u>			
		<u>VARIANCES</u>			
		<u>Flush Mount - Sidewalk</u>			
		<u>Grout Interval</u>			

7 CONTRACTOR'S OR LANDOWNER'S CERTIFICATION: This water well was (1) constructed, (2) reconstructed, or (3) plugged under my jurisdiction and was completed on (mo/day/year) 2-2-95 and this record is true to the best of my knowledge and belief. Kansas Water Well Contractor's License No. 575 This Water Well Record was completed on (mo/day/yr) 2-2-95 under the business name of Kurtz Environmental by (signature) _____

OFFICE USE ONLY