

CORRECTION TO WATER WELL RECORD (WWC-5)

The following correction(s) was made to the attached WWC-5 log in order to rectify lacking or incorrect information.

Fraction (1/4 1/4 1/4) Section-Township-Range changed:

listed as SW SW SE, 36

changed to SW SW SE, 36-9S-6E

Other changes: Initial statements: _____

Changed to: _____

Comments: _____

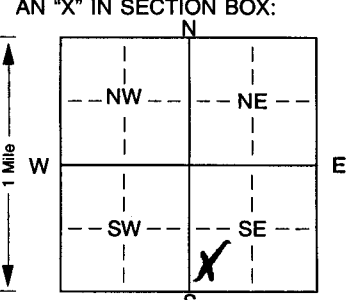
verification method: Written & legal descriptions, position on plat map,
and Heats 1:24,000 topo. map.

initials: DRD date: 11/26/2002

submitted by: Kansas Geological Survey, Data Resources Library, 1930 Constant Ave., Lawrence, KS 66047-3726
to: Kansas Dept of Health & Environment Bureau of Water Industrial Programs, Bldg 283, Forbes Field, KS 66620

1 LOCATION OF WATER WELL: Fraction SW 1/4 SW 1/4 SE 1/4 Section Number 36 Township Number T S R Range Number E W
 County: Riley Distance and direction from nearest town or city street address of well if located within city? In Klat's 2961 HEATE AVENUE

2 WATER WELL OWNER: R W Rensler
 RR#, St. Address, Box #: 6847 Anderson Avenue Board of Agriculture, Division of Water Resources
 City, State, ZIP Code: Manhattan, KS 66503 Application Number:

3 LOCATE WELL'S LOCATION WITH AN "X" IN SECTION BOX:

 4 DEPTH OF COMPLETED WELL: 60 ft. ELEVATION:
 Depth(s) Groundwater Encountered 1. 24 ft. 2. ft. 3. ft.
 WELL'S STATIC WATER LEVEL: 20 ft. below land surface measured on mo/day/yr
 Pump test data: Well water was ft. after hours pumping gpm
 Est. Yield: 20.7 gpm: Well water was ft. after hours pumping gpm
 Bore Hole Diameter: 10 in. to 60 ft., and in. to ft.
 WELL WATER TO BE USED AS:
 1 Domestic 3 Feedlot 6 Oil field water supply 9 Dewatering 12 Other (Specify below)
 2 Irrigation 4 Industrial 7 Domestic (lawn & garden) 10 Monitoring well
 Was a chemical/bacteriological sample submitted to Department? Yes. No. If yes, mo/day/yr sample was submitted
 Water Well Disinfected? Yes No

5 TYPE OF BLANK CASING USED:
 1 Steel 3 RMP (SR) 6 Asbestos-Cement 9 Other (specify below)
 2 PVC 4 ABS 7 Fiberglass Threaded
 Blank casing diameter: 8 in. to 40 ft. Dia. in. to ft. Dia. in. to ft.
 Casing height above land surface: 2' in., weight Sch 40 lbs./ft. Wall thickness or gauge No.
 TYPE OF SCREEN OR PERFORATION MATERIAL:
 1 Steel 3 Stainless steel 5 Fiberglass 7 PVC 10 Asbestos-cement
 2 Brass 4 Galvanized steel 6 Concrete tile 8 RMP (SR) 11 Other (specify)
 12 None used (open hole)
 SCREEN OR PERFORATION OPENINGS ARE:
 1 Continuous slot 3 Mill slot 10/100's 5 Gauzed wrapped 8 Saw cut 11 None (open hole)
 2 Louvered shutter 4 Key punched 6 Wire wrapped 9 Drilled holes
 7 Torch cut 10 Other (specify) ft.
 SCREEN-PERFORATED INTERVALS: From: 40 ft. to 60 ft., From ft. to ft.
 GRAVEL PACK INTERVALS: From: 25 ft. to 60 ft., From ft. to ft.

6 GROUT MATERIAL: 1 Neat cement 2 Cement grout 3 Bentonite 4 Other
 Grout Intervals: From: 3 ft. to 25 ft., From ft. to ft., From ft. to ft.
 What is the nearest source of possible contamination:
 1 Septic tank 4 Lateral lines 7 Pit privy 10 Livestock pens 14 Abandoned water well
 2 Sewer lines 5 Cess pool 8 Sewage lagoon 11 Fuel storage 15 Oil well/Gas well
 3 Watertight sewer lines 6 Seepage pit 9 Feedyard 12 Fertilizer storage 16 Other (specify below)
 13 Insecticide storage
 Direction from well? East How many feet? 100

FROM	TO	LITHOLOGIC LOG	FROM	TO	PLUGGING INTERVALS
0	1	Top Soil			
1	24	Brown Clay			
24	30	Sand & Gravel (Water)			
30	45	Limstone			
45	50	Grey Shale			
50	60	Limstone			

7 CONTRACTOR'S OR LANDOWNER'S CERTIFICATION: This water well was (1) constructed, (2) reconstructed, or (3) plugged under my jurisdiction and was completed on (mo/day/year) 11/26/2001 and this record is true to the best of my knowledge and belief. Kansas Water Well Contractor's Licence No. 451 This Water Well Record was completed on (mo/day/yr) 12/8/2001 under the business name of Holdiman Well Drilling by (signature) Craig E. Cupp