

CORRECTION(S) TO WATER WELL RECORD (WWC-5)

(to rectify lacking or incorrect information)

County: Riley

Location listed as:

Location changed to:

Section-Township-Range: 9-65-9E

9-95-6E

Fraction (1/4 1/4 1/4): SW NW SW

SW NW SW

Other changes: Initial statements: _____

Changed to: _____

Comments: _____

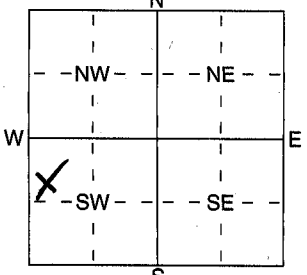
verification method: Written & legal descriptions, position on plat map,
and Riley 1:24,000 topo map (buildings shown on map).

initials: DRJ date: 10/24/2003

1 LOCATION OF WATER WELL: Fraction SW 1/4 NW 1/4 SW 1/4 Section Number 9 Township Number T 6 @ Range Number R 9 @ EW
 County: Riley

Distance and direction from nearest town or city street address of well if located within city? From Riley go 3 miles ~~west~~ East on 24 Hwy to Kutz Rd & Turn Right Then go 1/4 mile south & 1/4 mile EAST

2 WATER WELL OWNER: Kevin Sullivan
 RR#, St. Address, Box # : 11630 Anderson Board of Agriculture, Division of Water Resources
 City, State, ZIP Code : Riley, KS Application Number:

3 LOCATE WELL'S LOCATION WITHIN AN "X" IN SECTION BOX: DEPTH OF COMPLETED WELL 137 ft. ELEVATION:
 AN "X" IN SECTION BOX:

 Depth(s) Groundwater Encountered 1 82 ft. 2 ft. 3 ft.
 WELL'S STATIC WATER LEVEL 80 ft. below land surface measured on mo/day/yr
 Pump test data: Well water was ft. after hours pumping gpm
 Est. Yield 4 gpm: Well water was ft. after hours pumping gpm
 WELL WATER TO BE USED AS: 5 Public water supply 8 Air conditioning 11 Injection well
 1 Domestic 3 Feedlot 6 Oil field water supply 9 Dewatering 12 Other (Specify below)
 2 Irrigation 4 Industrial 7 Domestic (lawn & garden) 10 Monitoring well
 Was a chemical/bacteriological sample submitted to Department? Yes No; If yes, mo/day/yr sample was submitted
 Water Well Disinfected? Yes No

5 TYPE OF BLANK CASING USED: 1 Steel 3 RMP (SR) 5 Wrought iron 8 Concrete tile CASING JOINTS: Glued Clamped
2 PVC 4 ABS 6 Asbestos-Cement 9 Other (specify below) Welded
 7 Fiberglass Threaded
 Blank casing diameter 5' in. to 1.17 ft. Dia in. to ft., Dia in. to ft.
 Casing height above land surface 2 in., weight 29.40 lbs./ft. Wall thickness or gauge No.
 TYPE OF SCREEN OR PERFORATION MATERIAL: 7 PVC 10 Asbestos-Cement
 1 Steel 3 Stainless Steel 5 Fiberglass 8 RMP (SR) 11 Other (Specify)
 2 Brass 4 Galvanized Steel 6 Concrete tile 9 ABS 12 None used (open hole)
 SCREEN OR PERFORATION OPENINGS ARE: 25/100's 5 Gauzed wrapped 8 Saw cut 11 None (open hole)
 1 Continuous slot 3 Mill slot 6 Wire wrapped 9 Drilled holes
 2 Louvered shutter 4 Key punched 7 Torch cut 10 Other (specify) ft.
 SCREEN-PERFORATED INTERVALS: From 1.17 ft. to 137 ft., From ft. to ft.
 From ft. to ft., From ft. to ft.
 GRAVEL PACK INTERVALS: From 2.5 ft. to 137 ft., From ft. to ft.
 From ft. to ft., From ft. to ft.

6 GROUT MATERIAL: 1 Neat cement 2 Cement grout 3 Bentonite 4 Other
 Grout intervals: From 3 ft. to 2.5 ft., From ft. to ft., From ft. to ft.
 What is the nearest source of possible contamination:
 1 Septic tank 4 Lateral lines None Pit privy 10 Livestock pens 14 Abandoned water well
 2 Sewer lines 5 Cess pool 8 Sewage lagoon 12 Fertilizer storage 15 Oil well/Gas well
 3 Watertight sewer lines 6 Seepage pit 9 Feedyard 13 Insecticide storage 16 Other (specify below)
 Direction from well? How many feet?

FROM	TO	LITHOLOGIC LOG	FROM	TO	PLUGGING INTERVALS
0	1	Top Soil			
1	3	Brown clay			
3	18	Greenish shale			
18	22	Limestone			
22	51	Dark clay			
51	74	Limestone			
74	82	Greenish shale			
82	87	Limestone			
87	95	Greenish shale			
95	115	Limestone			
115	123	Green shale			
123	137	Limestone			

7 CONTRACTOR'S OR LANDOWNER'S CERTIFICATION: This water well was (1) constructed, (2) reconstructed, or (3) plugged under my jurisdiction and was completed on (mo/day/year) 2/13/2003 and this record is true to the best of my knowledge and belief. Kansas Water Well Contractor's Licence No. 851 This Water Well Record was completed on (mo/day/yr) 4/20/2003 under the business name of Halderman Well Drilling by (signature) Kevin Sullivan