


1 LOCATION OF WATER WELL: County: Riley Fraction: SE 1/4 NE 1/4 NE 1/4 Section Number: 7 Township Number: T 9 S Range Number: R 6 EW

Distance and direction from nearest town or city street address of well if located within city? 24 + 3/4 South From Riley 60 2 Miles East on

2 WATER WELL OWNER: James Rudolph  
 RR#, St. Address, Box #: 6660 North 52nd St  
 City, State, ZIP Code: Manhattan, KS 66503  
 Board of Agriculture, Division of Water Resources Application Number:

3 LOCATE WELL'S LOCATION WITH AN "X" IN SECTION BOX:

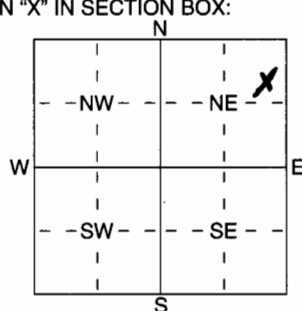

4 DEPTH OF COMPLETED WELL: 100 ft. ELEVATION:

Depth(s) Groundwater Encountered: 1 53 ft. 2 ..... ft. 3 ..... ft.  
 WELL'S STATIC WATER LEVEL: 50 ft. below land surface measured on mo/day/yr .....  
 Pump test data: Well water was ..... ft. after ..... hours pumping ..... gpm  
 Est. Yield: 25 gpm: Well water was ..... ft. after ..... hours pumping ..... gpm  
 WELL WATER TO BE USED AS:  
 1 Domestic     3 Feedlot     6 Oil field water supply     9 Dewatering     12 Other (Specify below)  
 2 Irrigation     4 Industrial     7 Domestic (lawn & garden)     10 Monitoring well

Was a chemical/bacteriological sample submitted to Department? Yes ..... No .....; If yes, mo/day/yr sample was submitted  
 Water Well Disinfected?  Yes     No

5 TYPE OF BLANK CASING USED:  
 1 Steel     3 RMP (SR)     5 Wrought iron     8 Concrete tile    CASING JOINTS:  Glued     Clamped .....  
 2 PVC     4 ABS     6 Asbestos-Cement     9 Other (specify below)     Welded .....  
 7 Fiberglass     Threaded .....

Blank casing diameter: 5 in. to 80 ft., Dia ..... in. to ..... ft., Dia ..... in. to ..... ft.  
 Casing height above land surface: 2' in., weight 54.40 lbs./ft. Wall thickness or gauge No. ....

TYPE OF SCREEN OR PERFORATION MATERIAL:  
 1 Steel     3 Stainless Steel     5 Fiberglass     8 RMP (SR)     10 Asbestos-Cement  
 2 Brass     4 Galvanized Steel     6 Concrete tile     9 ABS     11 Other (Specify) .....  
 12 None used (open hole)

SCREEN OR PERFORATION OPENINGS ARE:  
 1 Continuous slot     3 Mill slot 25/1000     5 Gauzed wrapped     8 Saw cut     11 None (open hole)  
 2 Louvered shutter     4 Key punched     6 Wire wrapped     9 Drilled holes  
 7 Torch cut     10 Other (specify) .....

SCREEN-PERFORATED INTERVALS: From 8.0 ft. to 100 ft., From ..... ft. to ..... ft.  
 GRAVEL PACK INTERVALS: From 2.5 ft. to 100 ft., From ..... ft. to ..... ft.

6 GROUT MATERIAL:  1 Neat cement     2 Cement grout     3 Bentonite     4 Other .....  
 Grout intervals: From 5 ft. to 25 ft., From ..... ft. to ..... ft., From ..... ft. to ..... ft.

What is the nearest source of possible contamination:  
 1 Septic tank     4 Lateral lines     None     10 Livestock pens     14 Abandoned water well  
 2 Sewer lines     5 Cess pool     8 Sewage lagoon     11 Fuel storage     15 Oil well/Gas well  
 3 Watertight sewer lines     6 Seepage pit     9 Feedyard     12 Fertilizer storage     16 Other (specify below)  
 13 Insecticide storage .....

Direction from well? How many feet?

FROM	TO	LITHOLOGIC LOG	FROM	TO	PLUGGING INTERVALS
0	1	Top Soil			
1	15	Brown Clay			
15	18	Limestone			
18	45	Reddish Brown Shale			
45	51	Limestone			
51	53	Brown Shale			
53	68	Limestone			
68	73	Greenish Shale			
73	100	Limestone			

7 CONTRACTOR'S OR LANDOWNER'S CERTIFICATION: This water well was  (1) constructed,  (2) reconstructed, or  (3) plugged under my jurisdiction and was completed on (mo/day/year) 6/3/2005 and this record is true to the best of my knowledge and belief. Kansas Water Well Contractor's Licence No. 451 This Water Well Record was completed on (mo/day/yr) 6/30/2005 under the business name of Holdman Well Drilling by (signature) Craig W. Cooper