

County: Riley Fraction: SW SW NW SE Sec. 36 T 9 S R 6 E

CORRECTION(S) TO WATER WELL COMPLETION RECORD (WWC-5) - to rectify lacking or incorrect information

Owner: Jeremy Sutton

If corrected, location was listed as:

Location changed to:

Section-Township-Range: 36 - T9 - R 6E

Fraction ($\frac{1}{4}$ $\frac{1}{4}$ $\frac{1}{4}$): none

SW SW NW SE

Other changes: Initial statements: Well use was Irrigation

Changed to: Changed well use to Domestic Lawn & Garden

Comments: _____

Verification method: Called owner of property to verify well use. Used
mapper for fractions

Initials: SK Date: 6-11-2020

Submitted by: ☒ Kansas Geological Survey, Data Resources Library, 1930 Constant Avenue, Lawrence, KS 66047-3724
☐ Kansas Dept. of Health & Environment, Bureau of Water, 1000 SW Jackson, Suite 420, Topeka, KS 66612-1367

WATER WELL PLUGGING RECORD Form WWC-5P

KSA 82a-1212

ID NO.

1 LOCATION OF WATER WELL: Fraction 36 Section Number 36 Township Number T 9 S 6 Range Number E 1 W
County: Riley

Street/Rural Address of Well Location; if unknown, distance & direction from nearest town or intersection: If at owner's address, check here ☒

Global Positioning Systems (GPS) information:

Latitude: 39.222097 (in decimal degrees)

Longitude: -96.7094281 (in decimal degrees)

Elevation: 1,128.4

Horizontal Datum: ☐ WGS84, ☒ NAD83, ☐ NAD27

Collection Method:

2 WATER WELL OWNER: Jeremy Sutton
RR#, St. Address, Box #: 7241 Blue Spruce Ln
City, State ZIP Code: Manhattan, KS 66503


☐ GPS unit (Make Model: _____)

☐ Digital Map/Photo, ☐ Topographic Map, ☐ Land Survey

LIDAR-EPIS

Est. Accuracy: ☐ < 3 m, ☐ 3-5 m, ☐ 5-15 m, ☐ > 15 m

3 MARK WELL'S LOCATION WITH AN "X" IN SECTION BOX:

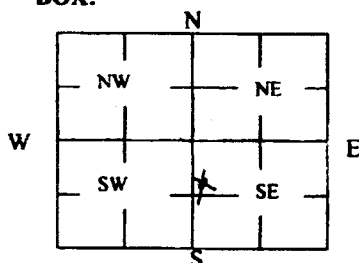

4 DEPTH OF WELL 28 ft. plus a 6 ft. Pit

WELL'S STATIC WATER LEVEL 6 ft. well in a 6 ft pit, thus 12 ft. from ground level

WELL WAS USED AS:

☒ Domestic
☐ Irrigation
☐ Feedlot
☐ Industrial

☐ Public Water Supply
☐ Oil Field Water Supply
☐ Domestic (Lawn & Garden)
☐ Air Conditioning

☐ Dewatering
☐ Monitoring
☐ Injection Well
☐ Other _____

Was a chemical/bacteriological sample submitted to Department? Yes ☐ No ☒

5 TYPE OF BLANK CASING USED:

☒ Steel
☐ PVC

☐ RMP (SR)
☐ ABS

☐ Wrought
☐ Asbestos-Cement

☐ Fiberglass
☐ Concrete Tile

☐ Other (Specify below) _____

RECEIVED

SEP 12 2019

Blank casing diameter 6 in. Was casing pulled? Yes ☐ No ☒ If yes, how much _____

Casing height above or below land surface -0.72 in.

BUREAU OF WATER

6 GROUT PLUG MATERIAL: ☒ Neat cement ☐ Cement grout ☒ Bentonite ☐ Other _____

Grout Plug Intervals: From 5 ft. to 1 ft., From 1 ft. to 0 ft., From _____ ft. to _____ ft.

What is the nearest source of possible contamination:

☒ Septic tank
☐ Sewer lines
☐ Watertight sewer lines
☐ Lateral lines
☐ Cess pool

☐ Seepage pit
☐ Pit privy
☐ Sewage lagoon
☐ Feedyard
☐ Livestock pens

☐ Fuel storage
☐ Fertilizer storage
☐ Insecticide storage
☐ Abandoned water well
☐ Oil well Gas well

☐ Other (specify below) _____

Direction from well? SE
How many feet? 15

FROM	TO	PLUGGING MATERIALS	FROM	TO	PLUGGING MATERIALS
28 ft	5 ft	Clean Disinfected Granular fill			
5 ft	1 ft	Ball natural Sodium Bentonite			
1 ft	0 ft	Concrete Pad over top			

7 CONTRACTOR'S OR LANDOWNER'S CERTIFICATION: This water well was plugged under my jurisdiction and was completed on (mo/day/year) 8/14/2019 and this record is true to the best of my knowledge and belief. Kansas Water Well Contractor's License No. owner. This Water Well Record was completed on (mo/day/year) 8/14/2019 under the business name of Jeremy Sutton (owner) by (signature) [Signature]

Send one white copy to Kansas Department of Health & Environment, Geology Section, 1000 SW Jackson Street, Ste. 420, Topeka, KS 66612-1367. Send one copy to WATER WELL OWNER and retain one for your records.

Visit us at <http://www.kdheks.gov/waterwell/index.html> Telephone 785-296-5524.

KSA82a-1212

Revised 1/20/2015