

WATER WELL PLUGGING RECORD

Form WWC-5P

KSA 82a-1212

ID NO.


1 LOCATION OF WATER WELL: Fraction SE 1/4 SE 1/4 NE 1/4 Section Number 6 Township Number T 9 N Range Number 6 NE

Street/Rural Address of Well Location; if unknown, distance & direction from nearest town or intersection: If at owner's address, check here 10830 Madison Ave. 24 Hwy

Global Positioning Systems (GPS) Information:
 Latitude: N 39° 12' 9.53" (in decimal degrees)
 Longitude: W 096° 47' 6.41" (in decimal degrees)
 Elevation: 1351
 Horizontal Datum: WGS84, NAD83, NAD27
 Collection Method:

2 WATER WELL OWNER: HARRY WHITNEY
 RR#, St. Address, Box #: 6590 Gambon Hill Rd.
 City, State ZIP Code: Manhattan, Mo 66503

GPS unit (Make/Model): Garmin E Teryx 20
 Digital Map/Photo, Topographic Map, Land Survey
 Est. Accuracy: <3 m, 3-5 m, 5-15 m, >15 m

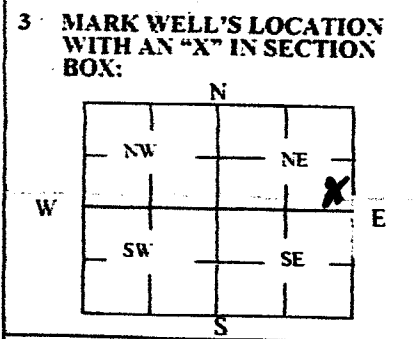

4 DEPTH OF WELL 100' ft.
 WELL'S STATIC WATER LEVEL 60' ft.
 WELL WAS USED AS:
 Domestic Public Water Supply Dewatering
 Irrigation Oil Field Water Supply Monitoring
 Feedlot Domestic (Lawn & Garden) Injection Well
 Industrial Air Conditioning Other _____
 Was a chemical/bacteriological sample submitted to Department? Yes No

5 TYPE OF BLANK CASING USED:
 Steel RMP (SR) Wrought Fiberglass Other (Specify below)
 PVC ABS Asbestos-Cement Concrete Tile WAS GALV. STEEL PIPE
 Blank casing diameter 5" in. Was casing pulled? Yes No If yes, how much CUT OFF 3' BELOW GROUND
 Casing height above or below land surface 3' BELOW GROUND

6 GROUT PLUG MATERIAL: Neat cement Cement grout Bentonite Other _____
 Grout Plug Intervals: From 3' ft. to 60' ft., From _____ ft. to _____ ft., From _____ ft. to _____ ft.

What is the nearest source of possible contamination:
 Septic tank Seepage pit Fuel storage Other (specify below)
 Sewer lines Pit privy Fertilizer storage
 Watertight sewer lines Sewage lagoon Insecticide storage
 Lateral lines Feedyard Abandoned water well
 Cess pool Livestock pens Oil well/Gas well
 Direction from well? SOUTH WEST
 How many feet? 150'

FROM	TO	PLUGGING MATERIALS	FROM	TO	PLUGGING MATERIALS
<u>0</u>	<u>3</u>	<u>COMPACTED CLAY</u>			
<u>3</u>	<u>60</u>	<u>BENTONITE CHIPS</u>			
<u>60</u>	<u>100</u>	<u>CHLORINATED GRAVEL</u>			

7 CONTRACTOR'S OR LANDOWNER'S CERTIFICATION: This water well was plugged under my jurisdiction and was completed on (mo/day/year) 9/19/2022 and this record is true to the best of my knowledge and belief. Kansas Water Well Contractor's License No. 451. This Water Well Record was completed on (mo/day/year) 9/16/2022 under the business name of Waldman Well Drilling by (signature) [Signature]

Send one white copy to Kansas Department of Health & Environment, Geology Section, 1000 SW Jackson Street, Ste. 420, Topeka, KS 66612-1367. Send one copy to WATER WELL OWNER and retain one for your records.
 Visit us at <http://www.kdheks.gov/waterwell/index.html> Telephone 785-296-5524.