


1 LOCATION OF WATER WELL: County: Riley Fraction: $\frac{1}{4}$ $\frac{1}{4}$ NE $\frac{1}{4}$ Section Number: 17 Township Number: T 9 S Range Number: R 6 EAW

Distance and direction from nearest town or city street address of well if located within city? From Riley Go 5 miles East on 24th Ave Go 1 1/2 miles South on 412 then Go 1/4 mile West on 60th St.

2 WATER WELL OWNER: Dani Allison
 RR#, St. Address, Box #: 10081 North 60th
 City, State, ZIP Code: Riley Kansas 66531
 Board of Agriculture, Division of Water Resources
 Application Number:

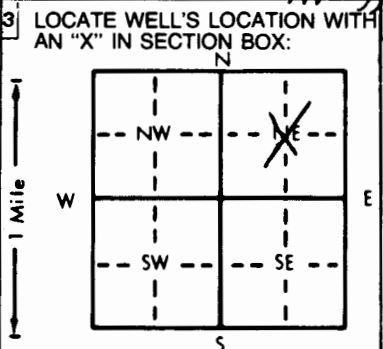

4 DEPTH OF COMPLETED WELL: 80' ft. ELEVATION:
 Depth(s) Groundwater Encountered 1. 45' ft. 2. ft. 3. ft.
 WELL'S STATIC WATER LEVEL: 40' ft. below land surface measured on mo/day/yr
 Pump test data: Well water was ft. after hours pumping gpm
 Est. Yield 576 gpm: Well water was ft. after hours pumping gpm
 Bore Hole Diameter: 8 in. to 80' ft., and in. to ft.
 WELL WATER TO BE USED AS:
 1 Domestic 3 Feedlot 6 Oil field water supply 9 Dewatering 12 Other (Specify below)
 2 Irrigation 4 Industrial 7 Lawn and garden only 10 Monitoring well
 Was a chemical/bacteriological sample submitted to Department? Yes.....No.....; If yes, mo/day/yr sample was submitted
 Water Well Disinfected? Yes No

5 TYPE OF BLANK CASING USED:
 1 Steel 3 RMP (SR) 6 Asbestos-Cement 9 Other (specify below)
 2 PVC 4 AS 7 Fiberglass
 Blank casing diameter: 5 1/2 in. to 60' ft., Dia. in. to ft., Dia. in. to ft.
 Casing height above land surface: 2 in., weight 5.1 lbs./ft. Wall thickness or gauge No.
 TYPE OF SCREEN OR PERFORATION MATERIAL:
 1 Steel 3 Stainless steel 5 Fiberglass 7 PVC 10 Asbestos-cement
 2 Brass 4 Galvanized steel 6 Concrete tile 9 ABS 11 Other (specify)
 12 None used (open hole)
 SCREEN OR PERFORATION OPENINGS ARE: 31 1000's
 1 Continuous slot 3 Mill slot 5 Gauzed wrapped 8 Saw cut 11 None (open hole)
 2 Louvered shutter 4 Key punched 6 Wire wrapped 9 Drilled holes
 7 Torch cut 10 Other (specify)
 SCREEN-PERFORATED INTERVALS: From 60 ft. to 80 ft., From ft. to ft.
 From ft. to ft., From ft. to ft.
 GRAVEL PACK INTERVALS: From 20 ft. to 80 ft., From ft. to ft.
 From ft. to ft., From ft. to ft.

6 GROUT MATERIAL: 1 Neat cement 2 Cement grout 3 Bentonite 4 Other
 Grout Intervals: From 0 ft. to 20 ft., From ft. to ft.
 What is the nearest source of possible contamination:
 1 Septic tank 4 Lateral lines 7 Pit privy 10 Livestock pens 14 Abandoned water well
 2 Sewer lines 5 Cess pool 8 Sewage lagoon 11 Fuel storage 15 Oil well/Gas well
 3 Watertight sewer lines 6 Seepage pit 9 Feedyard 12 Fertilizer storage 16 Other (specify below)
 13 Insecticide storage
 Direction from well? South East How many feet? 90'

FROM	TO	LITHOLOGIC LOG	FROM	TO	PLUGGING INTERVALS
0	4	Black Dirt Top Soil			
4	14	Brown Clay			
14	16	Shale Gray			
16	25	Rock			
25	28	Gray Shale			
28	29	Rock			
29	44	Gray Shale			
44	48	Rock (Water)			
48	57	Gray Shale			
57	80	Rock			

7 CONTRACTOR'S OR LANDOWNER'S CERTIFICATION: This water well was (1) constructed, (2) reconstructed, or (3) plugged under my jurisdiction and was completed on (mo/day/year) 5/26/88 and this record is true to the best of my knowledge and belief. Kansas Water Well Contractor's License No. 451 This Water Well Record was completed on (mo/day/yr) 6/19/88 under the business name of Haldeman Well Drilling by (signature) Craig Hal

OFFICE USE ONLY
T
R
EAW
SEC.