


1 LOCATION OF WATER WELL: County: Riley Fraction: NE 1/4 NE 1/4 SW 1/4 Section Number: 17 Township Number: T 9 S Range Number: R 6 E/W

Distance and direction from nearest town or city street address of well if located within city?  
From Keats 6.5 miles west on Anderson to 104th Ave + 6.5 mile southwest

2 WATER WELL OWNER: Stanley J Smith  
 RR#, St. Address, Box #: 5761 West 104th Ave  
 City, State, ZIP Code: Riley MO. KANSAS 66531  
 Board of Agriculture, Division of Water Resources  
 Application Number:

3 LOCATE WELL'S LOCATION WITH AN "X" IN SECTION BOX:

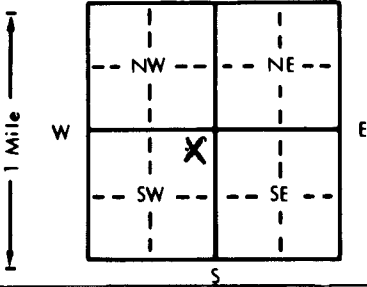

4 DEPTH OF COMPLETED WELL: 60' ft. ELEVATION:  
 Depth(s) Groundwater Encountered 1. 50' ft. 2. ft. 3. ft.  
 WELL'S STATIC WATER LEVEL: 20' ft. below land surface measured on mo/day/yr  
 Pump test data: Well water was ft. after hours pumping gpm  
 Est. Yield: 30 gpm Well water was ft. after hours pumping gpm  
 Bore Hole Diameter: 8 in. to 60' ft., and in. to ft.  
 WELL WATER TO BE USED AS:  
 1 Domestic  3 Feedlot  6 Oil field water supply  9 Dewatering  12 Other (Specify below)  
 2 Irrigation  4 Industrial  7 Lawn and garden only  10 Monitoring well  
 Was a chemical/bacteriological sample submitted to Department? Yes.....No. ; If yes, mo/day/yr sample was submitted  
 Water Well Disinfected?  Yes  No

5 TYPE OF BLANK CASING USED:  
 1 Steel  3 RMP (SR)  5 Wrought iron  8 Concrete tile CASING JOINTS:  Glued  Clamped  
 2 PVC  4 ABS  6 Asbestos-Cement  9 Other (specify below)  Welded  
 7 Fiberglass  Threaded

Blank casing diameter: 5 in. to 40 ft., Dia. in. to ft., Dia. in. to ft.  
 Casing height above land surface: 24" in., weight: SC 40 lbs./ft. Wall thickness or gauge No.

TYPE OF SCREEN OR PERFORATION MATERIAL:  
 1 Steel  3 Stainless steel  5 Fiberglass  7 PVC  10 Asbestos-cement  
 2 Brass  4 Galvanized steel  6 Concrete tile  9 ABS  11 Other (specify)

SCREEN OR PERFORATION OPENINGS ARE:  
 1 Continuous slot  3 Mill slot 3/1000  5 Gauzed wrapped  8 Saw cut  11 None (open hole)  
 2 Louvered shutter  4 Key punched  6 Wire wrapped  9 Drilled holes  
 7 Torch cut  10 Other (specify)

SCREEN-PERFORATED INTERVALS: From 40 ft. to 60 ft., From ft. to ft.  
 GRAVEL PACK INTERVALS: From 20 ft. to 60 ft., From ft. to ft.

6 GROUT MATERIAL:  1 Neat cement  2 Cement grout  3 Bentonite  4 Other  
 Grout intervals: From 0 ft. to 20 ft., From ft. to ft., From ft. to ft.

What is the nearest source of possible contamination:  
 1 Septic tank  4 Lateral lines  7 Pit privy  10 Livestock pens  14 Abandoned water well  
 2 Sewer lines  5 Cess pool  8 Sewage lagoon  11 Fuel storage  15 Oil well/Gas well  
 3 Watertight sewer lines  6 Seepage pit  9 Feedyard  12 Fertilizer storage  16 Other (specify below)  
 13 Insecticide storage

Direction from well? West How many feet? 200'

FROM	TO	LITHOLOGIC LOG	FROM	TO	PLUGGING INTERVALS
0	1	Top Soil			
1	2	Brown CLAY			
2	6	Soft Limestone			
6	10	Yellow SHALE			
10	16	Brown SHALE			
16	18	Grayish SHALE			
18	24	Brown SHALE			
24	30	Yellow Limestone			
30	36	Shale Yellow			
36	39	Limestone			
39	50	Grey stone			
50	54	Limestone			
54	60	Gray SHALE			

7 CONTRACTOR'S OR LANDOWNER'S CERTIFICATION: This water well was  (1) constructed,  (2) reconstructed, or  (3) plugged under my jurisdiction and was completed on (mo/day/year) 9/18/89 and this record is true to the best of my knowledge and belief. Kansas Water Well Contractor's License No. 450 This Water Well Record was completed on (mo/day/yr) 9/19/89 under the business name of HALDEMAN Well Drilling by (signature) Gray