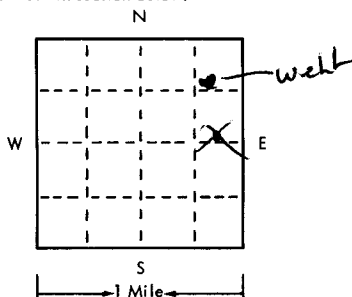



USE TYPEWRITER OR BALL POINT PEN-PRESS FIRMLY, PRINT CLEARLY.

9 6 E 35 SW NE NE
T R EW sec 1/4 1/4 1/4 No.

WATER WELL RECORD
KSA 82a-1201-1215

Kansas State Dept. Of Health
(Water Well Contractors)
Forbes-Bldg. 740
Topeka, Kansas 66620

1 Location of well:	County RILEY	Township name WILD CAT	Fraction SW 1/4 NE 1/4	Section number 35	Town number 9	Range number 6 E	
Distance and direction from nearest town or city: 1/2 mile west of Keats			3 Owner of well: Mayne Vassar Address: Route 1 Manhattan KS				
Locate with "X" in section below: 			Sketch map: 			4 Well depth: 60 ft. Date of completion 8-28-75 Well diameter 5 in.	
2 Type and color of material			From To		5 <input checked="" type="checkbox"/> Cable tool <input type="checkbox"/> Rotary <input type="checkbox"/> Driven <input type="checkbox"/> Dug <input type="checkbox"/> Hollow rod <input type="checkbox"/> Jetted <input type="checkbox"/> Bored <input type="checkbox"/> Reverse rotary		
					6 Use: <input checked="" type="checkbox"/> Domestic <input type="checkbox"/> Public supply <input type="checkbox"/> Industry <input type="checkbox"/> Irrigation <input type="checkbox"/> Air conditioning <input type="checkbox"/> Commercial <input type="checkbox"/> Test well <input type="checkbox"/>		
Sail seep brown clay Trace of gravel in brown clay Spongel Blue shale					7 Casing: Material PVC Height: above /below Threaded <input type="checkbox"/> Welded <input type="checkbox"/> Surface 2 in. Diam. 5 in. to 60 ft. depth Weight 2.57 lbs./ft. — in. to — ft. depth Drive shoe? <input type="checkbox"/> Yes <input checked="" type="checkbox"/> No		
					8 Screen: Manufacturer Pump Supply Type PVC Dia. 5 1/2 Slot/gauze Slot Length 101 Set between 35 ft. and 45 ft. Fittings: Gravel pack <input checked="" type="checkbox"/> Yes <input type="checkbox"/> No Size range of material PEA		
					9 Static water level: 30 ft. below land surface Date 8-28-75		
					10 Pumping level below land surfaces: — ft. after — hrs. pumping — g.p.m. — ft. after — hrs. pumping — g.p.m. Estimated maximum yield 15 g.p.m.		
					11 Water sample submitted: <input type="checkbox"/> Yes <input checked="" type="checkbox"/> No Date —		
					12 Well head completion: <input checked="" type="checkbox"/> Pitless adapter 18 inches above grade		
					13 Well grouted? <input checked="" type="checkbox"/> Yes <input type="checkbox"/> No <input checked="" type="checkbox"/> Neat cement <input type="checkbox"/> Bentonite <input type="checkbox"/> Depth: From 10 ft. to 20 ft.		
					14 Nearest source of possible contamination: ft. 100 Direction South Type Septic Well disinfected upon completion? <input checked="" type="checkbox"/> Yes <input type="checkbox"/> No		
					15 Pump: <input type="checkbox"/> Not installed Manufacturer's name Donpeter Model number L50 HP 1/2 Volts 23 Length of drop pipe 20 ft. capacity 15 g.p.m. Type: <input checked="" type="checkbox"/> Submersible <input type="checkbox"/> Turbine <input type="checkbox"/> Jet <input type="checkbox"/> Reciprocating <input type="checkbox"/> Centrifugal <input type="checkbox"/> Other		
					16 Remarks: elevation Topography: <input type="checkbox"/> Hill <input type="checkbox"/> Slope <input type="checkbox"/> Upland <input checked="" type="checkbox"/> Valley		
					17 Water well contractor's certification: This well was drilled under my jurisdiction and this report is true to the best of my knowledge and belief. Rayld Maly License No. 202A Business name _____ Address Route 4 Manhattan KS Signed Rayld Maly Date 8-28-75 Authorized representative		

T 9 R 6 E 35 SW NE NE

Forward the white, blue and pink copies to the Kansas State Dept. Of Health.

Form WWC-5