


1 LOCATION OF WATER WELL: County: RILEY Fraction: SE 1/4 NE 1/4 SE 1/4 Section Number: 36 Township Number: T 9 S Range Number: R 6

Distance and direction from nearest town or city street address of well if located within city?
1/4 EAST 1/4 NORTH FROM KEATS

2 WATER WELL OWNER: DONALD HANSON
RR#, St. Address, Box #: R22 Board of Agriculture, Division of Water Resources
City, State, ZIP Code: MANHATTAN, KS 66502 Application Number:

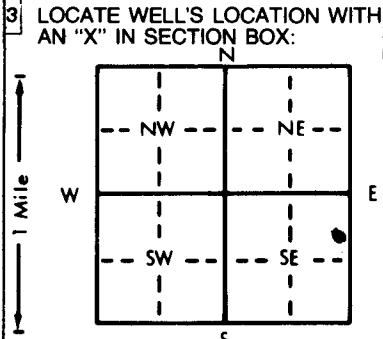

4 DEPTH OF COMPLETED WELL: 79' ft. ELEVATION: SLOPE
Depth(s) Groundwater Encountered 1. 48 ft. 2. ft. 3. ft.
WELL'S STATIC WATER LEVEL: 48 ft. below land surface measured on mo/day/yr 6-7-83
Pump test data: Well water was ft. after hours pumping gpm
Est. Yield 2 gpm: Well water was ft. after hours pumping gpm
Bore Hole Diameter: 8 in. to 79 ft., and in. to ft.
WELL WATER TO BE USED AS:
1 Domestic (circled) 3 Feedlot 6 Oil field water supply 9 Dewatering 12 Other (Specify below)
2 Irrigation 4 Industrial 7 Lawn and garden only 10 Observation well
Was a chemical/bacteriological sample submitted to Department? Yes No X; If yes, mo/day/yr sample was submitted
Water Well Disinfected? Yes X No

5 TYPE OF BLANK CASING USED:
1 Steel (circled) 3 RMP (SR) 5 Wrought iron 8 Concrete tile CASING JOINTS: Glued X Clamped
2 PVC (circled) 4 ABS 6 Asbestos-Cement 9 Other (specify below) Welded
7 Fiberglass Threaded
Blank casing diameter 5 in. to 79 ft., Dia. in. to ft., Dia. in. to ft.
Casing height above land surface: 2 1/4 in., weight 2.82 lbs./ft. Wall thickness or gauge No. 258
TYPE OF SCREEN OR PERFORATION MATERIAL:
1 Steel 3 Stainless steel 5 Fiberglass 7 RMP (SR) 10 Asbestos-cement
2 Brass 4 Galvanized steel 6 Concrete tile 9 ABS 11 Other (specify)
12 None used (open hole)
SCREEN OR PERFORATION OPENINGS ARE:
1 Continuous slot 3 Mill slot 5 Gauzed wrapped 6 Saw cut (circled) 11 None (open hole)
2 Louvered shutter 4 Key punched 7 Wire wrapped 9 Drilled holes
7 Torch cut 10 Other (specify)
SCREEN-PERFORATED INTERVALS: From 45 ft. to 60 ft., From ft. to ft.
GRAVEL PACK INTERVALS: From 0 ft. to 10 ft., From 20 ft. to 79 ft.
From ft. to ft., From ft. to ft.

6 GROUT MATERIAL: 1 Neat Cement 2 Cement grout 3 Bentonite 4 Other
Grout Intervals: From 10 ft. to 20 ft., From ft. to ft., From ft. to ft.
What is the nearest source of possible contamination:
1 Septic tank not installed yet Lateral lines 7 Pit privy 10 Livestock pens 14 Abandoned water well
2 Sewer lines 5 Cess pool 8 Sewage lagoon 11 Fuel storage 15 Oil well/Gas well
3 Watertight sewer lines 6 Seepage pit 9 Feedyard 12 Fertilizer storage 16 Other (specify below)
13 Insecticide storage

Direction from well? How many feet?

FROM	TO	LITHOLOGIC LOG	FROM	TO	LITHOLOGIC LOG
0	10	TOP SOIL			
10	20	FLINT ROCK			
20	35	GRAY SHALE			
35	41	GRAY ROCK			
41	48	GRAY SHALE			
48	51	GRAY ROCK (LITTLE WATER)			
51	79	GRAY SHALE			

7 CONTRACTOR'S OR LANDOWNER'S CERTIFICATION: This water well was (1) constructed (2) reconstructed, or (3) plugged under my jurisdiction and was completed on (mo/day/year) 6-7-83 and this record is true to the best of my knowledge and belief. Kansas Water Well Contractor's License No. 202 This Water Well Record was completed on (mo/day/yr) 6-7-83 under the business name of ENSLEY WELL DRILLING by signature Ray Enslley
INSTRUCTIONS: Use typewriter or ball point pen, PLEASE PRESS FIRMLY and PRINT clearly. Please fill in blanks, underline or circle the correct answers. Send top three copies to Kansas Department of Health and Environment, Division of Environment, Environmental Geology Section, Topeka, KS 66620. Send one to WATER WELL OWNER and retain one for your records.

OFFICE USE ONLY
T
R
6
36
SE 1/4 NE 1/4 SE 1/4

