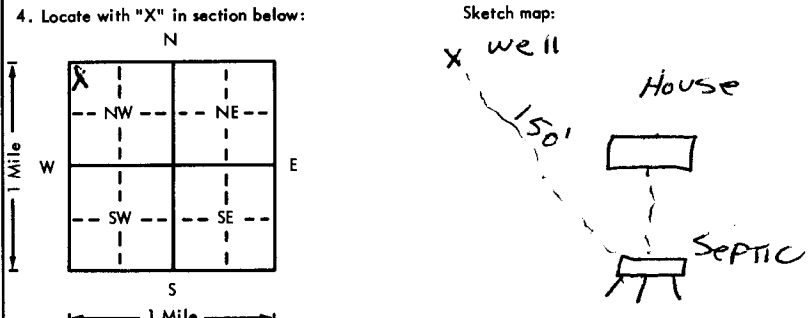


USE TYPEWRITER OR BALL POINT PEN-PRESS FIRMLY, PRINT CLEARLY.

WATER WELL RECORD
KSA 82a-1201-1215

Kansas Department of Health and Environment-Division of Environment
(Water well Contractors)
Topeka, Kansas 66620

LOT # 7

1. Location of well:	County Riley	Fraction NW 1/4 NW 1/4 NW 1/4	Section number 36	Township number T 9 S	Range number R 6 E/W
2. Distance and direction from nearest town or city: 3 W Street address of well location if in city: OF KEATS			3. Owner of well: JACK NEEF R.R. or street: RT 1 City, state, zip code: MANHATTAN, KS		
4. Locate with "X" in section below: 			6. Bore hole dia. 8 in. Completion date _____ Well depth 140 ft. 7-6-76		
			7. Cable tool <input checked="" type="checkbox"/> Rotary <input type="checkbox"/> Driven <input type="checkbox"/> Dug <input type="checkbox"/> Hollow rod <input type="checkbox"/> Jetted <input type="checkbox"/> Bored <input type="checkbox"/> Reverse rotary		
			8. Use: <input checked="" type="checkbox"/> Domestic <input type="checkbox"/> Public supply <input type="checkbox"/> Industry <input type="checkbox"/> Irrigation <input type="checkbox"/> Air conditioning <input type="checkbox"/> Stock <input type="checkbox"/> Lawn <input type="checkbox"/> Oil field water <input type="checkbox"/> Other		
			9. Casing: Material PVC Height Above or below Threaded <input type="checkbox"/> Welded <input type="checkbox"/> Surface 24 in. RMP PVC 94 Weight 258 lbs./ft. Dia. 5 in. to 140 ft. depth Wall Thickness: inches or Dia. _____ in. to _____ ft. depth Gauge No. 274		
5. Type and color of material			From	To	10. Screen: Manufacturer's name _____ Pumpco Type PVC Dia. 5 Slot gauge .060 Length 20 Set between 85 ft. and 105 ft. Gravel pack? <input checked="" type="checkbox"/> Size range of material 1/4 X 1/8
					11. Static water level: _____ mo./day/yr. 90 ft. below land surface Date 7-6-76
					12. Pumping level below land surfaces: AIR TEST _____ ft. after _____ hrs. pumping _____ g.p.m. _____ ft. after _____ hrs. pumping _____ g.p.m. Estimated maximum yield 8 g.p.m.
					13. Water sample submitted: _____ mo./day/yr. Yes <input checked="" type="checkbox"/> No <input type="checkbox"/> Date _____
					14. Well head completion: CAP <input type="checkbox"/> Pitless adapter 24 inches above grade
					15. Well grouted? <input checked="" type="checkbox"/> With: <input checked="" type="checkbox"/> Neat cement <input type="checkbox"/> Bentonite <input type="checkbox"/> Concrete Depth: From 5 ft. to 15 ft.
					16. Nearest source of possible contamination: ft. 150 Direction SE Type SEPTIC Well disinfected upon completion? <input checked="" type="checkbox"/> Yes <input type="checkbox"/> No
					17. Pump: <input checked="" type="checkbox"/> Not installed Manufacturer's name _____ Model number _____ HP _____ Volts _____ Length of drop pipe _____ ft. capacity _____ g.p.m. Type: <input type="checkbox"/> Submersible <input type="checkbox"/> Turbine <input type="checkbox"/> Jet <input type="checkbox"/> Reciprocating <input type="checkbox"/> Centrifugal <input type="checkbox"/> Other
(Use a second sheet if needed)					
18. Elevation: Topography: <input checked="" type="checkbox"/> Hill <input type="checkbox"/> Slope <input type="checkbox"/> Upland <input type="checkbox"/> Valley		19. Remarks: OWNER WILL INSTALL SLAB		20. Water well contractor's certification: This well was drilled under my jurisdiction and this report is true to the best of my knowledge and belief. STRADER Dalg Co Inc 182 Business name _____ License No. _____ Address RT 1 HOLTON, KS Signed Dale Peterson Date 7-7-76 Authorized representative	

2
 R
 6
 W
 36
 Sec
 1/4
 1/4
 1/4

Forward the white, blue and pink copies to the Department of Health and Environment

Form WWC-5