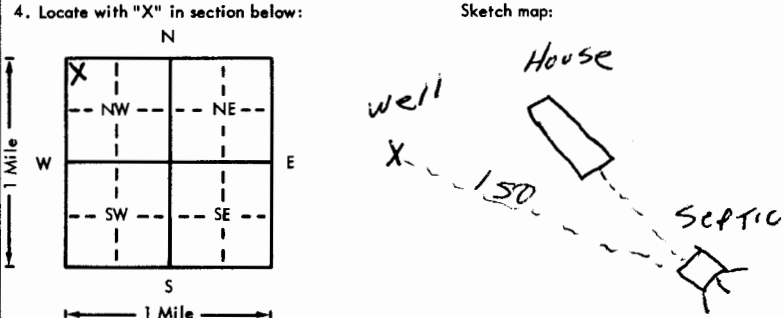


USE TYPEWRITER OR BALL POINT PEN-PRESS FIRMLY, PRINT CLEARLY.

WATER WELL RECORD
KSA 82a-1201-1215

Kansas Department of Health and Environment-Division of Environment
(Water well Contractors)
Topeka, Kansas 66620

LOT #6

1. Location of well:		County Riley	Fraction NW 1/4 NW 1/4 NW 1/4	Section number 36	Township number T 9 S R 6 E/W	Range number 6
2. Distance and direction from nearest town or city: .3 NW Street address of well location if in city: OF KEATS				3. Owner of well: JACK NEEF R.R. or street: RT1 City, state, zip code: MANHATTAN, KS.		
4. Locate with "X" in section below: Sketch map: 				6. Bore hole dia. 8 in. Completion date _____ Well depth 140 ft. 7-9-76		
5. Type and color of material				7. <input type="checkbox"/> Cable tool <input checked="" type="checkbox"/> Rotary <input type="checkbox"/> Driven <input type="checkbox"/> Dug <input type="checkbox"/> Hollow rod <input type="checkbox"/> Jetted <input type="checkbox"/> Bored <input type="checkbox"/> Reverse rotary		
				8. Use: <input checked="" type="checkbox"/> Domestic <input type="checkbox"/> Public supply <input type="checkbox"/> Industry <input type="checkbox"/> Irrigation <input type="checkbox"/> Air conditioning <input type="checkbox"/> Stock <input type="checkbox"/> Lawn <input type="checkbox"/> Oil field water <input type="checkbox"/> Other		
				9. Casing: Material PVC Height: Above or below Threaded <input type="checkbox"/> Welded <input type="checkbox"/> Surface 29 in. RMP <input type="checkbox"/> PVC 9L Weight 2.58 lbs./ft. Dia. 5 in. to 140 ft. depth Well Thickness: inches or Dia. _____ in. to _____ ft. depth gage No. 3.174		
				10. Screen: Manufacturer's name _____ Pumpco Type PVC Dia. 5 Slot/gauge .060 Length 20 Set between 85 ft. and 105 ft. Gravel pack? <input checked="" type="checkbox"/> Size range of material 1/4 X 1/8		
				11. Static water level: _____ mo./day/yr. 90 ft. below land surface Date 7-9-76		
				12. Pumping level below land surfaces: Air Test _____ ft. after _____ hrs. pumping _____ g.p.m. _____ ft. after _____ hrs. pumping _____ g.p.m. Estimated maximum yield 12 g.p.m.		
				13. Water sample submitted: _____ mo./day/yr. Yes <input type="checkbox"/> No <input checked="" type="checkbox"/> Date _____		
				14. Well head completion: CAP <input type="checkbox"/> Pitless adapter 24 inches above grade		
				15. Well grouted? <input checked="" type="checkbox"/> With: <input checked="" type="checkbox"/> Neat cement <input type="checkbox"/> Bentonite <input type="checkbox"/> Concrete Depth: From 5 ft. to 15 ft.		
				16. Nearest source of possible contamination: ft. 150 Direction SE Type SEPTIC Well disinfected upon completion? <input checked="" type="checkbox"/> Yes <input type="checkbox"/> No		
				17. Pump: <input checked="" type="checkbox"/> Not installed Manufacturer's name _____ Model number _____ HP _____ Volts _____ Length of drop pipe _____ ft. capacity _____ g.p.m. Type: <input type="checkbox"/> Submersible <input type="checkbox"/> Turbine <input type="checkbox"/> Jet <input type="checkbox"/> Reciprocating <input type="checkbox"/> Centrifugal <input type="checkbox"/> Other		
				(Use a second sheet if needed)		
18. Elevation:		19. Remarks: OWNER WILL INSTAL SLAB		20. Water well contractor's certification: This well was drilled under my jurisdiction and this report is true to the best of my knowledge and belief. STRADER DRIG CO INC 182 Business name _____ License No. _____ Address RT1 HOLTON, KS Signed Dele Anderson Date 7-12-76 Authorized representative		
Topography: <input checked="" type="checkbox"/> Hill <input type="checkbox"/> Slope <input type="checkbox"/> Upland <input type="checkbox"/> Valley						

T 9
 R 6
 W 36
 Sec 36
 1/4 1/4 1/4
 DWAN/DW

Forward the white, blue and pink copies to the Department of Health and Environment

Form WWC-5