USE TYPEWRITER OR BALL POINT PEN-PRESS FIRMLY, PRINT CLEARLY.

WATER WELL RECORD
KSA 82a-1201-1215

LOT # 9

Kansas Department of Health and Environment-Division of Environment
(Water well Contractors)
Topeka, Kansas 66620

1. Location of well:	County	Fraction	Section number	Township number	Range number
	Riley	NW 1/4 NW 1/4 NW 1/4	36	T 9 S	R 6 E/W

2. Distance and direction from nearest town or city: 3 NW
Street address of well location if in city: OF KEATS

3. Owner of well: JACK WEEF
R.R. or street: RT 1
City, state, zip code: MANHATTAN, KS

4. Locate with "X" in section below: Sketch map:

N / W / E / S / NW / NE / SW / SE / 1 Mile

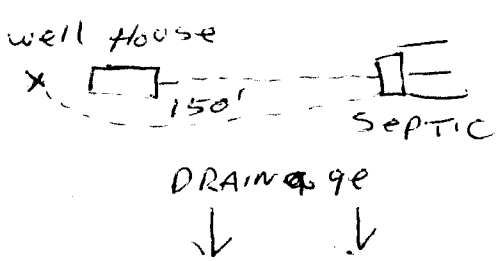

6. Bore hole dia. 8 in. Completion date
Well depth 120 ft. 7-7-76

7. __ Cable tool ✓ Rotary __ Driven __ Dug
__ Hollow rod __ Jetted __ Bored __ Reverse rotary

8. Use: ✓ Domestic __ Public supply __ Industry
__ Irrigation __ Air conditioning __ Stock
__ Lawn __ Oil field water __ Other

9. Casing: Material PVC Height: Above or below
Threaded ___ Welded ___ Surface 24 in.
RMP ___ PVC ✓ Weight 2.58 lbs./ft.
Dia. 5 in. to 120 ft. depth Wall Thickness: inches or
Dia. ___ in. to ___ ft. depth gage No. 2.79

5. Type and color of material	From	To
Top Soil	0	3
yellow clay	3	14
grey Lime	14	35
grey shale	35	41
grey Lime	41	60
Red shale	60	68
yellow Lime (20gpm)	68	71
grey shaley Lime	71	109
grey Lime	109	120

(Use a second sheet if needed)

10. Screen: Manufacturer's name PUMPCO
Type PVC Dia. 5
Slot/gauze .060 Length 20
Set between 60 ft. and 80 ft.
___ ft. and ___ ft.
Gravel pack? ✓ Size range of material 1/4 x 1/8

11. Static water level: mo./day/yr.
70 ft. below land surface Date 7-7-76

12. Pumping level below land surfaces: Air Test
___ ft. after ___ hrs. pumping ___ g.p.m.
___ ft. after ___ hrs. pumping ___ g.p.m.
Estimated maximum yield 20 g.p.m.

13. Water sample submitted: mo./day/yr.
___ Yes ✓ No Date

14. Well head completion: CAP
___ Pitless adapter 24 Inches above grade

15. Well grouted? ✓
With: ✓ Neat cement ___ Bentonite ___ Concrete
Depth: From 5 ft. to 15 ft.

16. Nearest source of possible contamination:
ft. 150 Direction E Type SEPTIC
Well disinfected upon completion? ✓ Yes ___ No

17. Pump: ✓ Not installed
Manufacturer's name
Model number ___ HP ___ Volts ___
Length of drop pipe ___ ft. capacity ___ g.p.m.
Type:
___ Submersible ___ Turbine
___ Jet ___ Reciprocating
___ Centrifugal ___ Other

18. Elevation:
Topography:
✓ Hill
___ Slope
___ Upland
___ Valley

19. Remarks:
owner will INSTAL slab

20. Water well contractor's certification:
This well was drilled under my jurisdiction and this report is true to the best of my knowledge and belief.
STRADER Drlg. Co., Inc 182
Business name License No.
Address RT 1 HOLTON, KS
Signed Dale Anderson Date 7-8-76
Authorized representative

T 9 R 6 E/W Sec 36 1/4 NW 1/4 NW 1/4 NW

Forward the white, blue and pink copies to the Department of Health and Environment

Form WWC-5

MI-1023