


1 LOCATION OF WATER WELL: County: Riley 081 Fraction: NE 1/4 NE 1/4 NE 1/4 Section Number: 28 Township Number: T 9 S Range Number: R 6 E/W

Distance and direction from nearest town or city street address of well if located within city? 412 To Priddy Country + Ga 1/2 Mile North + 1/4 Mile East From Heats 60 4 miles west on

2 WATER WELL OWNER: RAGON G. JACQUART Application Number: Riley Co. Permit # 34801
 RR#, St. Address, Box #: 4604 Freeman Rd. Board of Agriculture, Division of Water Resources
 City, State, ZIP Code: Manhattan, KS 66502

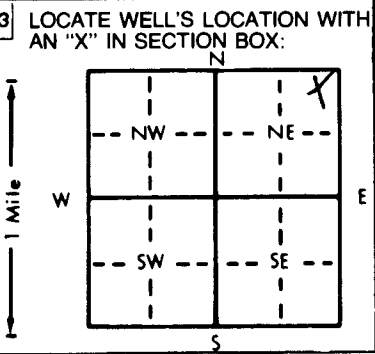

4 DEPTH OF COMPLETED WELL: 120 ft. ELEVATION: _____ ft.
 Depth(s) Groundwater Encountered 1. 78 ft. 2. _____ ft. 3. _____ ft.
 WELL'S STATIC WATER LEVEL: 78 ft. below land surface measured on mo/day/yr
 Pump test data: Well water was _____ ft. after _____ hours pumping _____ gpm
 Est. Yield 11 gpm Well water was _____ ft. after _____ hours pumping _____ gpm
 Bore Hole Diameter: 7 in. to 120' ft., and _____ in. to _____ ft.
 WELL WATER TO BE USED AS:
 1 Domestic 3 Feedlot 6 Oil field water supply 9 Dewatering 12 Other (Specify below)
 2 Irrigation 4 Industrial 7 Lawn and garden only 10 Monitoring well
 Was a chemical/bacteriological sample submitted to Department? Yes _____ No _____; If yes, mo/day/yr sample was submitted _____
 Water Well Disinfected? Yes No

5 TYPE OF BLANK CASING USED:
 1 Steel 3 RMP (SR) 5 Wrought iron 8 Concrete tile CASING JOINTS: Glued Clamped
 2 PVC 4 ABS 6 Asbestos-Cement 9 Other (specify below) Welded
 7 Fiberglass Threaded
 Blank casing diameter: 5 in. to 100 ft., Dia _____ in. to _____ ft., Dia _____ in. to _____ ft.
 Casing height above land surface: 2 in., weight 54.40 lbs./ft. Wall thickness or gauge No. _____
 TYPE OF SCREEN OR PERFORATION MATERIAL:
 1 Steel 3 Stainless steel 5 Fiberglass 7 PVC 10 Asbestos-cement
 2 Brass 4 Galvanized steel 6 Concrete tile 8 RMP (SR) 11 Other (specify) _____
 12 None used (open hole)
 SCREEN OR PERFORATION OPENINGS ARE:
 1 Continuous slot 3 Mill slot 25/1000 5 Gauzed wrapped 8 Saw cut 11 None (open hole)
 2 Louvered shutter 4 Key punched 6 Wire wrapped 9 Drilled holes
 7 Torch cut 10 Other (specify) _____
 SCREEN-PERFORATED INTERVALS: From 10.0 ft. to 120 ft., From _____ ft. to _____ ft.
 From _____ ft. to _____ ft., From _____ ft. to _____ ft.
 GRAVEL PACK INTERVALS: From 25 ft. to 120 ft., From _____ ft. to _____ ft.
 From _____ ft. to _____ ft., From _____ ft. to _____ ft.

6 GROUT MATERIAL: 1 Neat cement 2 Cement grout 3 Bentonite 4 Other _____
 Grout Intervals: From 0 ft. to 25 ft., From _____ ft. to _____ ft., From _____ ft. to _____ ft.
 What is the nearest source of possible contamination: None Close
 1 Septic tank 4 Lateral lines 7 Pit privy 10 Livestock pens 14 Abandoned water well
 2 Sewer lines 5 Cess pool 8 Sewage lagoon 11 Fuel storage 15 Oil well/Gas well
 3 Watertight sewer lines 6 Seepage pit 9 Feedyard 12 Fertilizer storage 16 Other (specify below)
 13 Insecticide storage
 Direction from well? _____ How many feet? _____

| FROM | TO | LITHOLOGIC LOG | FROM | TO | PLUGGING INTERVALS |
|------|-----|--------------------|------|----|--------------------|
| 0 | 2 | Top Soil | | | |
| 2 | 4 | Brown Clay | | | |
| 4 | 13 | Limestone | | | |
| 13 | 21 | yellow shale | | | |
| 21 | 32 | Greenish shale | | | |
| 32 | 36 | yellow shale | | | |
| 36 | 47 | Limestone | | | |
| 47 | 51 | Brown shale | | | |
| 51 | 55 | Grey shale | | | |
| 55 | 62 | Limestone | | | |
| 62 | 78 | Grey shale (water) | | | |
| 78 | 96 | Limestone | | | |
| 96 | 105 | yellow shale | | | |
| 10.5 | 120 | Greenish shale | | | |

7 CONTRACTOR'S OR LANDOWNER'S CERTIFICATION: This water well was (1) constructed, (2) reconstructed, or (3) plugged under my jurisdiction and was completed on (mo/day/year) 1/25/95 and this record is true to the best of my knowledge and belief. Kansas Water Well Contractor's License No. 451 This Water Well Record was completed on (mo/day/yr) 2/5/95 under the business name of Holdeman Well Drilling by (signature) Craig H. GWP/PE

OFFICE USE ONLY
T
R
EW
SEC.