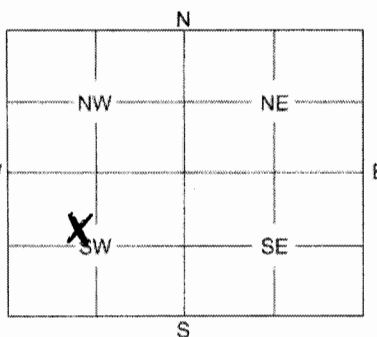


1 LOCATION OF WATER WELL: County: <b>Riley</b>	Fraction <b>SE<sup>1</sup>/<sub>4</sub> NW<sup>1</sup>/<sub>4</sub> SW<sup>1</sup>/<sub>4</sub></b>	Section Number <b>21</b>	Township Number <b>9</b>	Range Number <b>7</b> <span style="float:right; border: 1px solid black; border-radius: 50%; padding: 2px;">E/W</span>
---------------------------------------------------	---	-----------------------------	-----------------------------	---

Distance and direction from nearest town or city street address of well if located within city?  
**approximately 300 feet west of 6245 Tuttle Creek Blvd, Manhattan Kansas 66503**


2 WATER WELL OWNER: <b>Riley County Shop</b> RR #, St. Address, Box #: <b>2711 Anderson</b> City, State, ZIP Code : <b>Manhattan, Ks 66502</b>	Board of Agriculture, Division of Water Resources Application Number:
---	--------------------------------------------------------------------------

3 MARK WELL'S LOCATION WITH AN "X" IN SECTION BOX: 	4 DEPTH OF WELL ..... <b>31.54</b> ..... ft. WELL'S STATIC WATER LEVEL <b>21.81</b> ... ft. WELL WAS USED AS: <table style="width:100%; border: none;"> <tr> <td style="width:33%;">1 Domestic</td> <td style="width:33%;">5 Public Water Supply</td> <td style="width:33%;">9 Dewatering</td> </tr> <tr> <td>2 Irrigation</td> <td>6 Oil Field Water Supply</td> <td><input checked="" type="radio"/> 10 Monitoring Well</td> </tr> <tr> <td>3 Feediot</td> <td>7 Domestic (Lawn &amp; Garden)</td> <td>11 Injection Well</td> </tr> <tr> <td>4 Industrial</td> <td>8 Air Conditioning</td> <td>12 Other .....</td> </tr> </table> <p>Was a chemical / bacteriological sample submitted to Department? Yes ..... No <input checked="" type="checkbox"/> .....</p> <p>If yes, mo/day/yr sample was submitted .....</p> <p>Water Well Disinfected: Yes .

5 TYPE OF BLANK CASING USED: <table style="width:100%; border: none;"> <tr> <td>1 Steel</td> <td>3 RMP (SR)</td> <td>5 Wrought</td> <td>7 Fiberglass</td> <td>9 Other (Specify below)</td> </tr> <tr> <td><input checked="" type="radio"/> 2 PVC</td> <td>4 ABS</td> <td>6 Asbestos-Cement</td> <td>8 Concrete Tile</td> <td></td> </tr> </table>	1 Steel	3 RMP (SR)	5 Wrought	7 Fiberglass	9 Other (Specify below)	<input checked="" type="radio"/> 2 PVC	4 ABS	6 Asbestos-Cement	8 Concrete Tile		Blank casing diameter <b>2</b> in. Was casing pulled? Yes ..... No <input checked="" type="checkbox"/> ..... If yes, how much <b>20'</b> Casing height above or below land surface ..... in.

6 GROUT PLUG MATERIAL: 1 Neat cement <input checked="" type="radio"/> 2 Cement grout <input checked="" type="radio"/> 3 Bentonite <input checked="" type="radio"/> 4 Other .....	Grout Plug Intervals: From <b>3</b> <b>20</b> ft. to <b>3</b> ft., From <b>2</b> <b>3</b> ft. to <b>0</b> ft., From ..... to ..... ft.																				
What is the nearest source of possible contamination: <table style="width:100%; border: none;"> <tr> <td>1 Septic tank</td> <td>6 Seepage pit</td> <td>11 Fuel storage</td> <td><input checked="" type="radio"/> 16 Other (specify below)</td> </tr> <tr> <td>2 Sewer lines</td> <td>7 Pit privy</td> <td>12 Fertilizer storage</td> <td></td> </tr> <tr> <td>3 Watertight sewer lines</td> <td>8 Sewage lagoon</td> <td>13 Insecticide storage</td> <td></td> </tr> <tr> <td>4 Lateral lines</td> <td>9 Feedyard</td> <td>14 Abandoned water well</td> <td></td> </tr> <tr> <td>5 Cess pool</td> <td>10 Livestock pens</td> <td>15 Oil well/Gas well</td> <td></td> </tr>
Direction from well? ..... How many feet? .....																					

FROM	TO	PLUGGING MATERIALS
20	3	<b>Bentonite</b>
3	0	<b>Surface Silts/Clays</b>

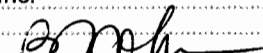7 CONTRACTOR'S OF LANDOWNER'S CERTIFICATION: This water well was plugged under my jurisdiction and was completed on (mo/day/year) <b>02/13/06</b> and this record is true to the best of my knowledge and belief. Kansas Water Well Contractor's License No. <b>585</b> This Water Well Record was completed on (mo/day/year) <b>02/21/06</b> under the business name of <b>Associated Environmental, Inc.</b> by (signature) <b>Bradley J. Johnson</b>	
---	---------------------------------------------------------------------------------------

INSTRUCTIONS: Use typewriter or ball point pen. Please press firmly and print clearly. Please fill in blanks, underline or circle the correct answers. Send top three copies to Kansas Department of Health and Environment, Bureau of Water, Geology Section, 1000 SW Jackson St., Ste. 420, Topeka, Kansas 66612-1367. Telephone: 785/296-5522. Send one to Water Well Owner and retain one for your records.