


1 LOCATION OF WATER WELL: Fraction NN 1/4 NW 1/4 NW 1/4 Section Number 25 Township Number T 9 S Range Number R 7 Q/W
 County: Riley

Distance and direction from nearest town or city street address of well if located within city? From Manhattan go 4 miles North on 24 Hwy to Bent Trk Drive to 2727 Bent Trk

2 WATER WELL OWNER: Ghost Marsha McCaffrey III Riley County Pump
 RR#, St. Address, Box #: P.O. Box 277 2727 Bent Trk Board of Agriculture, Division of Water Resources
 City, State, ZIP Code: Manhattan, KS 66505 Application Number:

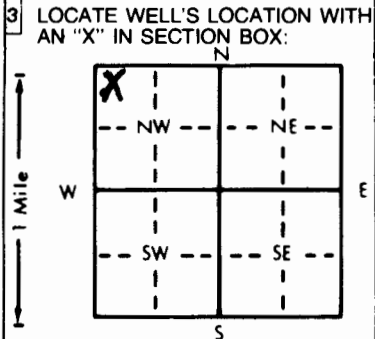

4 DEPTH OF COMPLETED WELL: 30 ft. ELEVATION: 10 ft. below land surface measured on mo/day/yr
 Depth(s) Groundwater Encountered: 1 ft. 2. 19 ft. 3. 10 ft.
 WELL'S STATIC WATER LEVEL: 10 ft. below land surface measured on mo/day/yr
 Pump test data: Well water was 50 gpm: Well water was 10 ft. after 30 hours pumping 10 gpm
 Est. Yield: 50 gpm: Well water was 10 ft. after 30 hours pumping 10 gpm
 Bore Hole Diameter: 10 in. to 30 in. and 1/2 in. to 1/2 in. Pump
 WELL WATER TO BE USED AS:
 1 Domestic 5 Public water supply 8 Air conditioning 11 Injection well
 2 Irrigation 3 Feedlot 6 Oil field water supply 9 Dewatering 12 Other (Specify below)
 4 Industrial 7 Lawn and garden only 10 Monitoring well
 Was a chemical/bacteriological sample submitted to Department? Yes No No Yes: If yes, mo/day/yr sample was submitted Water Well Disinfected Yes Yes No

5 TYPE OF BLANK CASING USED:
 1 Steel 2 PVC 3 RMP (SR) 4 ABS 5 Wrought iron 6 Asbestos-Cement 7 Fiberglass 8 Concrete tile 9 Other (specify below) CASING JOINTS: Glued Clamped Welded Threaded
 Blank casing diameter: 5 in. to 20 in. Dia. 31 in. to 31 in. Dia. 50 lbs./ft. Wall thickness or gauge No. Sch 40
 Casing height above land surface: 31 in. weight Sch 40
 TYPE OF SCREEN OR PERFORATION MATERIAL:
 1 Steel 2 Brass 3 Stainless steel 4 Galvanized steel 5 Fiberglass 6 Concrete tile 7 PVC 8 RMP (SR) 9 ABS 10 Asbestos-cement 11 Other (specify) 12 None used (open hole)
 SCREEN OR PERFORATION OPENINGS ARE:
 1 Continuous slot 2 Louvered shutter 3 Mill slot 10/1000 4 Key punched 5 Gauzed wrapped 6 Wire wrapped 7 Torch cut 8 Saw cut 9 Drilled holes 10 Other (specify) 11 None (open hole)
 SCREEN-PERFORATED INTERVALS: From 20 ft. to 30 ft. From 20 ft. to 30 ft. From 20 ft. to 30 ft. From 20 ft. to 30 ft.
 GRAVEL PACK INTERVALS: From 20 ft. to 30 ft. From 20 ft. to 30 ft. From 20 ft. to 30 ft. From 20 ft. to 30 ft.

6 GROUT MATERIAL: 1 Neat cement 2 Cement grout 3 Bentonite 4 Other
 What is the nearest source of possible contamination:
 1 Septic tank 2 Sewer lines 3 Watertight sewer lines 4 Lateral lines 5 Cess pool 6 Seepage 7 Pit privy 8 Sewage lagoon 9 Feedyard 10 Livestock pens 11 Fuel storage 12 Fertilizer storage 13 Insecticide storage 14 Abandoned water well 15 Oil well/Gas well 16 Other (specify below)
 Direction from well? South 330' How many feet? 330'

FROM	TO	LITHOLOGIC LOG	FROM	TO	PLUGGING INTERVALS
0	2	Top Soil			
2	14	Brown Clay			
14	26	Gravel (Water)			
26	30	Grey shale			

7 CONTRACTOR'S OR LANDOWNER'S CERTIFICATION: This water well was (1) constructed, (2) reconstructed, or (3) plugged under my jurisdiction and was completed on (mo/day/year) 6/11/98 and this record is true to the best of my knowledge and belief. Kansas Water Well Contractor's License No. 451 This Water Well Record was completed on (mo/day/yr) 6/25/98 under the business name of Holdinger Well Drilling by (signature) Way L. WID/PT

OFFICE USE ONLY
T
R
EW
SEC.
1/4
1/4
1/4