

**WATER WELL PLUGGING RECORD Form WWC-5P KSA 82a-1212 ID NO.**


I-2

<b>1 LOCATION OF WATER WELL:</b> County: <u>Riley</u>	Fraction <u>¼ SW¼ NW¼ NW¼</u>	Section Number <u>25</u>	Township Number <u>T 09 S</u>	Range Number <u>07</u> <input checked="" type="checkbox"/> E <input type="checkbox"/> W
--	----------------------------------	-----------------------------	----------------------------------	--

Street/Rural Address of Well Location; if unknown, distance & direction from nearest town or intersection: If at owner's address, check here  End of Rory Rd in Manhattan, KS

**Global Positioning Systems (GPS) information:**  
 Latitude: \_\_\_\_\_ (in decimal degrees)  
 Longitude: \_\_\_\_\_ (in decimal degrees)  
 Elevation: \_\_\_\_\_  
 Horizontal Datum:  WGS84,  NAD83,  NAD27  
 Collection Method:  
 GPS unit (Make/Model: \_\_\_\_\_)  
 Digital Map/Photo,  Topographic Map,  Land Survey  
 Est. Accuracy:  < 3 m,  3-5 m,  5-15 m,  > 15 m

**2 WATER WELL OWNER: KDHE-BER**  
 RR#, St. Address, Box #: 1000 SW Jackson; Ste. 410  
 City, State ZIP Code: Topeka, KS 66601

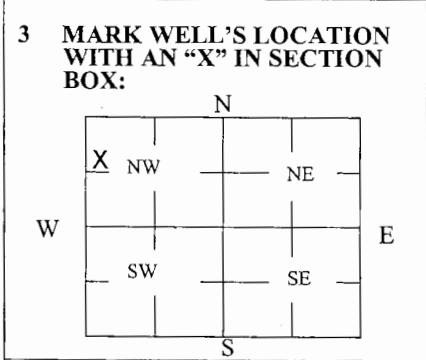

**4 DEPTH OF WELL** 84.75 **ft.**  
 WELL'S STATIC WATER LEVEL 49.93 **ft**  
 WELL WAS USED AS:  
 Domestic  Public Water Supply  Dewatering  
 Irrigation  Oil Field Water Supply  Monitoring  
 Feedlot  Domestic (Lawn & Garden)  Injection Well  
 Industrial  Air Conditioning  Other \_\_\_\_\_  
 Was a chemical/bacteriological sample submitted to Department? Yes  No

**5 TYPE OF BLANK CASING USED:**

Steel  RMP (SR)  Wrought  Fiberglass  Other (Specify below) \_\_\_\_\_  
 PVC  ABS  Asbestos-Cement  Concrete Tile

Blank casing diameter 0.75 in. Was casing pulled? Yes  No  If yes, how much 10 ft  
 Casing height above or below land surface 120 in.

**6 GROUT PLUG MATERIAL:**  Neat cement  Cement grout  Bentonite  Other \_\_\_\_\_

Grout Plug Intervals: From 3 ft. to 84.75 ft., From \_\_\_\_\_ ft. to \_\_\_\_\_ ft., From \_\_\_\_\_ ft. to \_\_\_\_\_ ft.

What is the nearest source of possible contamination:  
 Septic tank  Seepage pit  Fuel storage  Other (specify below) A5-081-40022  
 Sewer lines  Pit privy  Fertilizer storage  
 Watertight sewer lines  Sewage lagoon  Insecticide storage  
 Lateral lines  Feedyard  Abandoned water well Direction from well? Northeast  
 Cess pool  Livestock pens  Oil well/Gas well How many feet? 795

FROM	TO	PLUGGING MATERIALS	FROM	TO	PLUGGING MATERIALS
0	3	Compacted Silts/Clays			
3	84.75	Hydrated Bentonite			


**7 CONTRACTOR'S OR LANDOWNER'S CERTIFICATION:** This water well was plugged under my jurisdiction and was completed on (mo/day/year) 10/29/18 and this record is true to the best of my knowledge and belief. Kansas Water Well Contractor's License No. 585. This Water Well Record was completed on (mo/day/year) 10/30/18 under the business name of Associated Environmental, Inc. by (signature) [Signature]

Send one white copy to Kansas Department of Health & Environment, Geology Section, 1000 SW Jackson Street, Ste. 420, Topeka, KS 66612-1367. Send one copy to WATER WELL OWNER and retain one for your records.  
 Visit us at <http://www.kdheks.gov/waterwell/index.html> Telephone 785-296-5524.

Kiley

SW NW NW

25-9-7

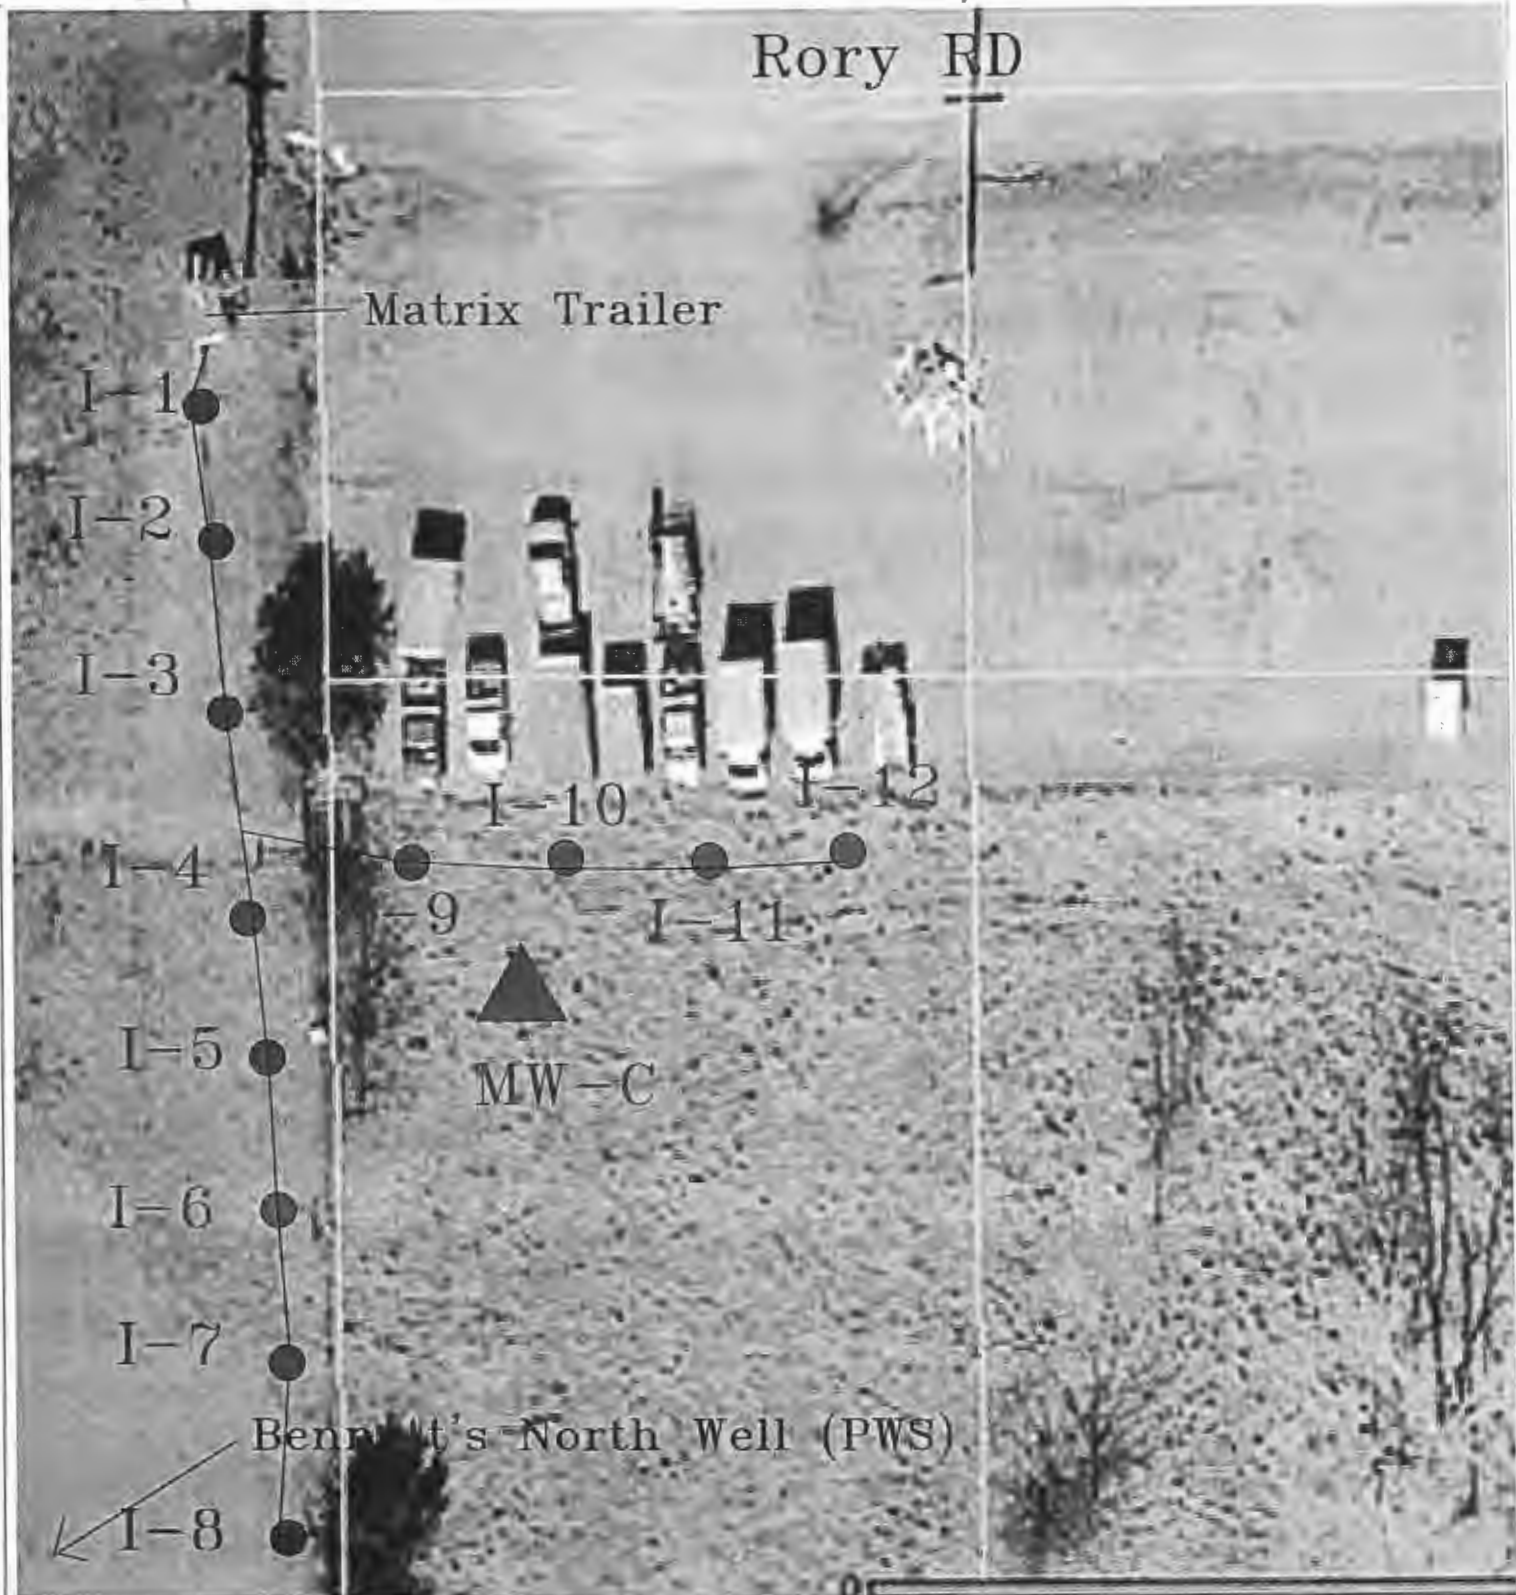

PROJECT: Lakeside/Enoch Oil

ADDRESS: 3221 Tuttle Creek Blvd.

LOCATION: Manhattan, Kansas

DRAWN BY: B. Johnson      DATE: 06/21/10

REVISED BY:      DATE:

AD JOB #      KICHE JOB #      A5-081-40022

TITLE: Matrix Injection Point locations

ASSOCIATED ENVIRONMENTAL INC.

LEGEND:

● = Abandoned Injection Point location

▲ = MW-C location



SCALE: