

County: Riley Fraction: NW NW SW NE Sec. 17 T. 9 S R. 7 E

CORRECTION(S) to WATER WELL COMPLETION RECORD Form WWC-5 (to rectify lacking or incorrect information)

Owner: Glenn Jenny Household

If location corrected, was listed as:

Location changed to:

Section-Township-Range: _____

Fraction (¼ calls): NW SE NE

NW NW SW NE

Other changes: Initial statements: _____

Changed to: _____

Comments: Well Fractions changed from NW SE NE to NW NW SW NE
based on entering LAT and LON in LEO WEB NAD83 and on WWC5 Interactive Map.

Verification method: Confirmed using LEO Web NAD83 and WWC5 Interactive Map.

Initials: RS Date: 03-28-2023

Submitted by: Kansas Geological Survey, Data Resources Library, 1930 Constant Ave., Lawrence, KS 66047-3724
 Kansas Dept. of Health & Environment, Bureau of Water, 1000 SW Jackson, Suite 420, Topeka, KS 66612-1367

WATER WELL RECORD Form WWC-5


Division of Water Resources App. No.

Well ID

Original Record Correction Change in Well Use

1 LOCATION OF WATER WELL:
 County: Reboy Fraction: NW 5 E 1/4 NE 1/4 Section Number: 17 Township Number: T 9 S Range Number: R 7 E W

2 WELL OWNER: Last Name: GLENN First: JENNY
 Business: 6129 Tumbelwood Terris
 Address: MANHATTAN State: KS ZIP: 66502
 Street or Rural Address where well is located (if unknown, distance and direction from nearest town or intersection): From Manhattan go 7 miles north west on Hwy 10 to Gumbo Mill Rd. Turn east to 63rd Ave. Go north 1/2 mile to Posture on Right

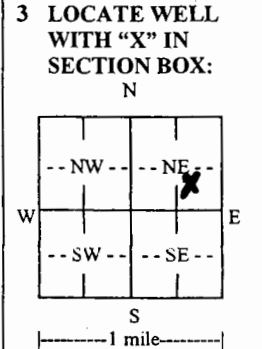

4 DEPTH OF COMPLETED WELL: 180 ft.
 Depth(s) Groundwater Encountered: 1) 148 ft.
 2) 145 ft. 3) 140 ft., or 4) Dry Well
 WELL'S STATIC WATER LEVEL: 145 ft.
 below land surface, measured on (mo-day-yr) 10/20/2022
 above land surface, measured on (mo-day-yr)
 Pump test data: Well water was ft. after hours pumping gpm
 Well water was ft. after hours pumping gpm
 Estimated Yield: 6.9 gpm
 Bore Hole Diameter: 9" in. to 180 ft. and in. to ft.

5 Latitude: N. 39° 16.336 (decimal degrees)
Longitude: W. 096° 40.305 (decimal degrees)
 Horizontal Datum: WGS 84 NAD 83 NAD 27
 Source for Latitude/Longitude: GPS (unit make/model: Garmin ETRIX 20)
 (WAAS enabled? Yes No)
 Land Survey Topographic Map
 Online Mapper:
6 Elevation: 1,305' ft. Ground Level TOC
 Source: Land Survey GPS Topographic Map
 Other:

7 WELL WATER TO BE USED AS:

1. <input checked="" type="checkbox"/> Domestic: <input checked="" type="checkbox"/> Household <input type="checkbox"/> Lawn & Garden <input type="checkbox"/> Livestock	2. <input type="checkbox"/> Irrigation	3. <input type="checkbox"/> Feedlot	4. <input type="checkbox"/> Industrial	5. <input type="checkbox"/> Public Water Supply: well ID <u> </u>	6. <input type="checkbox"/> Dewatering: how many wells? <u> </u>	7. <input type="checkbox"/> Aquifer Recharge: well ID <u> </u>	8. <input type="checkbox"/> Monitoring: well ID <u> </u>	9. Environmental Remediation: well ID <u> </u> <input type="checkbox"/> Air Sparge <input type="checkbox"/> Soil Vapor Extraction <input type="checkbox"/> Recovery <input type="checkbox"/> Injection	10. <input type="checkbox"/> Oil Field Water Supply: lease <u> </u>	11. Test Hole: well ID <u> </u> <input type="checkbox"/> Cased <input type="checkbox"/> Uncased <input type="checkbox"/> Geotechnical	12. Geothermal: how many bores? <u> </u> a) Closed Loop <input type="checkbox"/> Horizontal <input type="checkbox"/> Vertical b) Open Loop <input type="checkbox"/> Surface Discharge <input type="checkbox"/> Inj. of Water	13. <input type="checkbox"/> Other (specify): <u> </u>
---	--	-------------------------------------	--	---	--	--	--	--	---	--	--	--

Was a chemical/bacteriological sample submitted to KDHE? Yes No If yes, date sample was submitted:
 Water well disinfected? Yes No

8 TYPE OF CASING USED: Steel PVC Other CASING JOINTS: Glued Clamped Welded Threaded
 Casing diameter 3" in. to 160 ft., Diameter in. to ft., Diameter in. to ft.
 Casing height above land surface 3' in. Weight Sch 40 lbs./ft. Wall thickness or gauge No.
 TYPE OF SCREEN OR PERFORATION MATERIAL:
 Steel Stainless Steel Fiberglass PVC Other (Specify)
 Brass Galvanized Steel Concrete tile None used (open hole)
 SCREEN OR PERFORATION OPENINGS ARE:
 Continuous Slot Mill Slot Gauze Wrapped Torch Cut Drilled Holes Other (Specify)
 Louvered Shutter Key Punched Wire Wrapped Saw Cut None (Open Hole)
 SCREEN-PERFORATED INTERVALS: From 160 ft. to 180 ft., From ft. to ft., From ft. to ft.
 GRAVEL PACK INTERVALS: From 42 ft. to 180 ft., From ft. to ft., From ft. to ft.

9 GROUT MATERIAL: Neat cement Cement grout Bentonite Other
 Grout Intervals: From 51 ft. to 42 ft., From ft. to ft., From ft. to ft.
 Nearest source of possible contamination: None Close
 Septic Tank Lateral Lines Pit Privy Livestock Pens Insecticide Storage
 Sewer Lines Cess Pool Sewage Lagoon Fuel Storage Abandoned Water Well
 Watertight Sewer Lines Seepage Pit Feedyard Fertilizer Storage Oil Well/Gas Well
 Other (Specify)
 Direction from well? Distance from well? ft.

10 FROM	TO	LITHOLOGIC LOG	FROM	TO	LITHO. LOG (cont.) or PLUGGING INTERVALS
0	1	Top Soil	93	106	Limestone
1	5	Limestone	106	122	Grey shale
5	6	Tan shale	122	131	Limestone
6	21	Limestone	131	146	Brown shale
21	51	Brown shale	146	154	Limestone (Water)
51	54	Limestone	154	160	Brown shale
54	61	Grey shale	160-167		Limestone
61	78	Limestone	167-180		Grey oily shale - Dark
78	93	Tan shale			

11 CONTRACTOR'S OR LANDOWNER'S CERTIFICATION: This water well was constructed, reconstructed, or plugged under my jurisdiction and was completed on (mo-day-year) 10/20/2022 and this record is true to the best of my knowledge and belief. Kansas Water Well Contractor's License No. 451. This Water Well Record was completed on (mo-day-year) 10/27/2022 under the business name of Haldeman Well Drilling Company, LLC

Mail 1 white copy along with a fee of \$5.00 for each constructed well to: Kansas Department of Health and Environment, Bureau of Water, GWTS Section, 1000 SW Jackson St., Suite 420, Topeka, Kansas 66612-1367. Mail one to Water Well Owner and retain one for your records. Telephone 785-296-5524.