


1 LOCATION OF WATER WELL: County: Riley Fraction: W 1/2 SE 1/4 SE 1/4 Section Number: 6 Township Number: T 9 (S) Range Number: R 7 (EW)

Distance and direction from nearest town or city street address of well if located within city? From City of Manhattan, Mo. 113 3 miles North to 24 + 605 miles West to County 402 + 60 75 yrd + Turn North on Township Road 60 2 miles

2 WATER WELL OWNER: HARRY WHITNEY  
 RR#, St. Address, Box #: RR #4  
 City, State, ZIP Code: Manhattan, Mo 66502  
 Board of Agriculture, Division of Water Resources  
 Application Number:

3 LOCATE WELL'S LOCATION WITH AN "X" IN SECTION BOX:

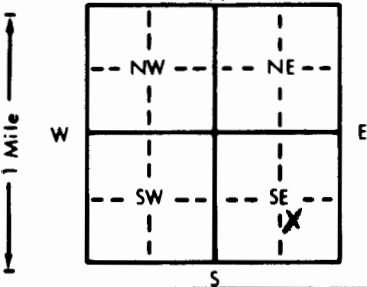

4 DEPTH OF COMPLETED WELL: 120' ft. ELEVATION:  
 Depth(s) Groundwater Encountered 1. 100' ft. 2. ft. 3. ft.  
 WELL'S STATIC WATER LEVEL: 97' ft. below land surface measured on mo/day/yr  
 Pump test data: Well water was ft. after hours pumping gpm  
 Est. Yield 6 gpm Well water was ft. after hours pumping gpm  
 Bore Hole Diameter: 8" in. to 120' ft., and in. to ft.  
 WELL WATER TO BE USED AS:  
 1 Domestic  3 Feedlot  6 Oil field water supply  9 Dewatering  12 Other (Specify below)  
 2 Irrigation  4 Industrial  7 Lawn and garden only  10 Observation well  
 Was a chemical/bacteriological sample submitted to Department? Yes No ; If yes, mo/day/yr sample was submitted  
 Water Well Disinfected? Yes  No

5 TYPE OF BLANK CASING USED:  
 1 Steel 3 RMP (SR) 5 Wrought iron 8 Concrete tile CASING JOINTS: Glued  Clamped  
 2 PVC 4 ABS 6 Asbestos-Cement 9 Other (specify below) Welded  
 7 Fiberglass Threaded  
 Blank casing diameter 120' in. to 100' ft., Dia. in. to ft., Dia. in. to ft.  
 Casing height above land surface 3' in., weight lbs./ft. Wall thickness or gauge No.

TYPE OF SCREEN OR PERFORATION MATERIAL:  
 1 Steel 3 Stainless steel 5 Fiberglass 8 RMP (SR) 10 Asbestos-cement  
 2 Brass 4 Galvanized steel 6 Concrete tile 9 ABS 11 Other (specify)  
 12 None used (open hole)

SCREEN OR PERFORATION OPENINGS ARE: 3 1/1000  
 1 Continuous slot 3 Mill slot 5 Gauzed wrapped 8 Saw cut 11 None (open hole)  
 2 Louvered shutter 4 Key punched 6 Wire wrapped 9 Drilled holes  
 7 Torch cut 10 Other (specify)

SCREEN-PERFORATED INTERVALS: From 100' ft. to 120' ft., From ft. to ft.  
 From ft. to ft., From ft. to ft.  
 GRAVEL PACK INTERVALS: From 15' ft. to 120' ft., From ft. to ft.  
 From ft. to ft., From ft. to ft.

6 GROUT MATERIAL:  Neat cement 2 Cement grout 3 Bentonite 4 Other  
 Grout Intervals: From 5' ft. to 15' ft., From ft. to ft., From ft. to ft.

What is the nearest source of possible contamination: NONE CLOSE  
 1 Septic tank 4 Lateral lines 7 Pit privy 10 Livestock pens 14 Abandoned water well  
 2 Sewer lines 5 Cess pool 8 Sewage lagoon 11 Fuel storage 15 Oil well/Gas well  
 3 Watertight sewer lines 6 Seepage pit 9 Feedyard 12 Fertilizer storage 16 Other (specify below)  
 13 Insecticide storage

Direction from well? How many feet?

FROM	TO	LITHOLOGIC LOG	FROM	TO	LITHOLOGIC LOG
0	5	Brown clay	75	80	Brown clay
5	10	Yellow clay	80	86	Rock
10	11	Rock	86	96	Brown clay
11	13	Green clay	96	100	Clay
13	21	Rock	100	117	Rock
21	34	Brown clay	117	120	Shale
34	36	Rock			
36	37	Shale			
37	38	Rock			
38	56	Brown clay			
56	59	Rock			
59	62	Shale			
62	68	Rock			
68	71	Brown clay			
71	75	Rock			

7 CONTRACTOR'S OR LANDOWNER'S CERTIFICATION: This water well was (1) constructed, (2) reconstructed, or (3) plugged under my jurisdiction and was completed on (mo/day/year) 5/16/85 and this record is true to the best of my knowledge and belief. Kansas Water Well Contractor's License No. 451 This Water Well Record was completed on (mo/day/yr) 5/16/85 under the business name of Haldeman Well Drilling by (signature) Craig Hal

INSTRUCTIONS: Use typewriter or ball point pen, PLEASE PRESS FIRMLY and PRINT clearly. Please fill in blanks, underline or circle the correct answers. Send top three copies to Kansas Department of Health and Environment, Division of Environment, Environmental Geology Section, Topeka, KS 66620. Send one to WATER WELL OWNER and retain one for your records.