


1 LOCATION OF WATER WELL: County: Riley Fraction: SW 1/4 NE 1/4 NE 1/4 Section Number: 7 Township Number: T 9 S Range Number: R 7 E

Distance and direction from nearest town or city street address of well if located within city? From Manhattan Go West on 1133 Miles To 1777 Then Go North 3 Miles To Gumbo Hill Rd + Go 1/2 mile To 63rd Ave. + Go 1 Mile North

2 WATER WELL OWNER: Richard Todd Smith  
 RR#, St. Address, Box #: 1920 Mill Road Board of Agriculture, Division of Water Resources  
 City, State, ZIP Code: Manhattan, KS 66502 Application Number:

3 LOCATE WELL'S LOCATION WITH AN "X" IN SECTION BOX:

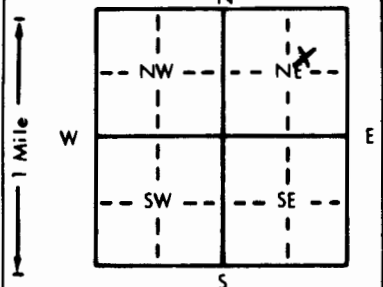

4 DEPTH OF COMPLETED WELL: 120' ft. ELEVATION: .....  
 Depth(s) Groundwater Encountered 1. 78' ft. 2. .... ft. 3. .... ft.  
 WELL'S STATIC WATER LEVEL 70 ft. below land surface measured on mo/day/yr  
 Pump test data: Well water was ..... ft. after ..... hours pumping ..... gpm  
 Est. Yield 2.5 gpm: Well water was ..... ft. after ..... hours pumping ..... gpm  
 Bore Hole Diameter 9 in. to 120' ft., and ..... in. to ..... ft.  
 WELL WATER TO BE USED AS: 5 Public water supply 8 Air conditioning 11 Injection well  
 1 Domestic 3 Feedlot 6 Oil field water supply 9 Dewatering 12 Other (Specify below)  
 2 Irrigation 4 Industrial 7 Lawn and garden only 10 Monitoring well  
 Was a chemical/bacteriological sample submitted to Department? Yes.....No.....; If yes, mo/day/yr sample was submitted  
 Water Well Disinfected?  Yes No

5 TYPE OF BLANK CASING USED: 5 Wrought iron 8 Concrete tile CASING JOINTS:  Glued  Clamped  
 2 PVC 3 RMP (SR) 6 Asbestos-Cement 9 Other (specify below)  Welded  Screened  
 4 ABS 7 Fiberglass ..... Threaded.

Blank casing diameter 5 in. to 100 ft., Dia. in. to ..... ft., Dia. in. to ..... ft.  
 Casing height above land surface 2' in., weight Sch 40 lbs./ft. Wall thickness or gauge No. ....

TYPE OF SCREEN OR PERFORATION MATERIAL:  7 PVC 10 Asbestos-cement  
 1 Steel 3 Stainless steel 5 Fiberglass 8 RMP (SR) 11 Other (specify) .....  
 2 Brass 4 Galvanized steel 6 Concrete tile 9 ABS 12 None used (open hole)

SCREEN OR PERFORATION OPENINGS ARE: 5 Gauzed wrapped 8 Saw cut 11 None (open hole)  
 1 Continuous slot  3 Mill slot 3/1000's 6 Wire wrapped 9 Drilled holes  
 2 Louvered shutter 4 Key punched 7 Torch cut 10 Other (specify) .....

SCREEN-PERFORATED INTERVALS: From 100 ft. to 120 ft., From ..... ft. to ..... ft.  
 From ..... ft. to ..... ft., From ..... ft. to ..... ft.  
 GRAVEL PACK INTERVALS: From 25 ft. to 120 ft., From ..... ft. to ..... ft.  
 From ..... ft. to ..... ft., From ..... ft. to ..... ft.

6 GROUT MATERIAL: 1 Neat cement 2 Cement grout  3 Bentonite 4 Other  
 Grout Intervals: From 0 ft. to 25 ft., From ..... ft. to Environment ft. From ..... ft. to ..... ft.

What is the nearest source of possible contamination: None Close  
 1 Septic tank 4 Lateral lines 7 Pit privy 10 Livestock pens 14 Abandoned water well  
 2 Sewer lines 5 Cess pool 8 Sewage lagoon 11 Fuel storage 15 Oil well/Gas well  
 3 Watertight sewer lines 6 Seepage pit 9 Feedyard 12 Fertilizer storage 16 Other (specify below)  
 13 Insecticide storage

Direction from well? ..... How many feet? .....

FROM	TO	LITHOLOGIC LOG	FROM	TO	PLUGGING INTERVALS
0	1	Top Soil	45	51	yellow shale
1	3	Brown Shale	51	64	Brown shale
3	5	Limestone	64	68	Limestone
5	7	Yellow shale	68	74	yellow shale
7	9	FLINT ROCK	74	78	Brown shale
9	11	Limestone	78	97	Limestone (Water)
11	12	Yellow Shale	97	110	Grey shale
12	22	Brown Shale	110	114	Brown shale
22	27	Grey Shale	114	117	Limestone
27	28	Limestone	117	120	Brown Shale
28	34	Grey Shale			
34	36	Green Shale			
36	43	Limestone			
43	44	Greenish shale			
44	45	Limestone			

7 CONTRACTOR'S OR LANDOWNER'S CERTIFICATION: This water well was  (1) constructed,  (2) reconstructed, or  (3) plugged under my jurisdiction and was completed on (mo/day/year) 7/16/91 and this record is true to the best of my knowledge and belief. Kansas Water Well Contractor's License No. 451 This Water Well Record was completed on (mo/day/yr) 8/10/91 under the business name of Halckman Well Drilling by (signature) Craig H. CWD/PI