


USE TYPEWRITER OR BALL POINT PEN - PRESS FIRMLY PRINT CLEARLY.

WATER WELL RECORD  
KSA 201-1215


Kansas Department of Health and Environment - Division of Environment  
(Water well Contractors)  
Topeka, Kansas 66620

14-9-7

NW SW NE 14  
17  
9

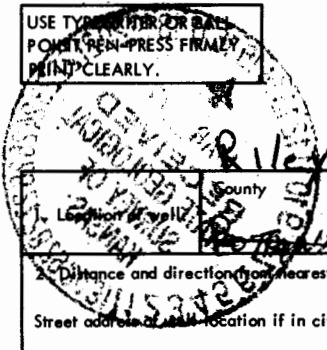

1. Location of well: Riley County  
 Fraction: NW 1/4 SW 1/4 NE 1/4  
 Section number: 21  
 Township number: 8  
 Range number: 7 EW  
 2. Distance and direction from nearest town or city: 5 NW  
 Street address at well location if in city: OF MANHATTAN  
 3. Owner of well: GARY BURNETT  
 R.R. or street:  
 City, state, zip code: MANHATTAN, KS.

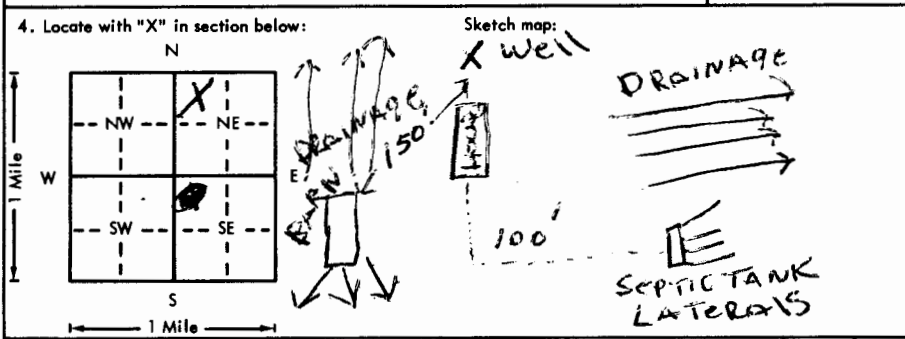

6. Bore hole dia. 10 in. Completion date 11-16-75  
 Well depth 275 ft.  
 7.  Cable tool  Rotary  Driven  Dug  
 Hollow rod  Jetted  Bored  Reverse rotary  
 8. Use:  Domestic  Public supply  Industry  
 Irrigation  Air conditioning  Stock  
 Lawn  Oil field water  Other  
 9. Casing: Material PLTS Height Above or below  
 Threaded  Welded  Surface 24 in.  
 RMP PVC 9L Weight 2.33 lbs./ft.  
 Dia. 5 in. to 275 ft. depth Wall Thickness: inches or  
 Dia.    in. to    ft. depth Gage No. 214

5. Type and color of material

	From	To
Limestone (yellow - soft - loose)	0	35
Red shale	35	40
Shaley Limestone (yellow - soft)	40	90
Limestone - (Brown)	90	105
Shaley Limestone (yellow - red - brown)	105	170
Blue shale	170	210
Grey Limestone	210	212
Red shale	212	230
Limestone (soft - porous - loose - yellow)	230	235
Shale - (black)	235	250
Grey Limestone (hard)	250	255
Grey shale	255	267
Blue shale	267	275

10. Screen: Manufacturer's name PUMCO  
 Type PVC Dia. 5  
 (S) gauze 80 Length 40  
 Set between 215 ft. and 255 ft.  
 Gravel pack?  Size range of material 1/4 x 1/8  
 11. Static water level: 140 ft. below land surface Date 11-16-75 mo./day/yr.  
 12. Pumping level below land surfaces: AIR TEST  
   ft. after    hrs. pumping    g.p.m.  
   ft. after    hrs. pumping    g.p.m.  
 Estimated maximum yield 30 g.p.m.  
 13. Water sample submitted:    mo./day/yr.  
 Yes  No  Date     
 14. Well head completion: CAPPED  
 Pitless adapter 24 inches above grade  
 15. Well grouted? yes  
 With:  Neat cement  Bentonite  Concrete  
 Depth: From 0 ft. to 20 ft.  
 16. Nearest source of possible contamination:  
 ft. 100 Direction S Type SEPTIC TANK  
 Well disinfected upon completion?  Yes  No  
 17. Pump:  Not installed  
 Manufacturer's name    HP    Volts     
 Model number    Length of drop pipe    ft. capacity    g.p.m.  
 Type:  
 Submersible  Turbine  
 Jet  Reciprocating  
 Centrifugal  Other

18. Elevation: 1925  
 Topography:  
 Hill  
 Slope  
 Upland  
 Valley

19. Remarks:  
Drone Williams  
will install 3' sq. - slab

20. Water well contractor's certification:  
 This well was drilled under my jurisdiction and this report is true to the best of my knowledge and belief.  
Stender Del. Co Inc 182  
 Business name License No.  
 Address RT1, Holton KS  
 Signed Dale Anderson Date 11-16-75  
 Authorized representative

2-20-75  
 1/4 1/4 1/4 1/4  
 Sec 14  
 T 8 R 7 E