


1 LOCATION OF WATER WELL: County: Riley Fraction: NC 1/4 E 1/2 1/4 SE 1/4 Section Number: 21 Township Number: T 9 S Range Number: R 7 E/W

Distance and direction from nearest town or city street address of well if located within city? From Manhattan Go 3 1/2 Miles North on Highway 113 Then Go 1 mile West on Highway 197 Then Go 1/2 mile South

2 WATER WELL OWNER: CLAY WATAHA  
 RR#, St. Address, Box #: 7821 Tuttle Creek Blvd.  
 City, State, ZIP Code: Manhattan, Kansas 66502  
 Board of Agriculture, Division of Water Resources  
 Application Number:

3 LOCATE WELL'S LOCATION WITH AN "X" IN SECTION BOX:  
 4 DEPTH OF COMPLETED WELL: 100' ft. ELEVATION:  
 Depth(s) Groundwater Encountered 1. 66' ft. 2. ft. 3. ft.

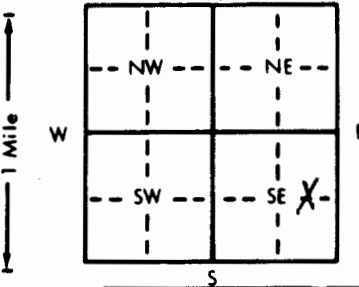

WELL'S STATIC WATER LEVEL 60 ft. below land surface measured on mo/day/yr  
 Pump test data: Well water was ft. after hours pumping gpm  
 Est. Yield 20 gpm: Well water was ft. after hours pumping gpm  
 Bore Hole Diameter 8 in. to 100' ft., and in. to ft.  
 WELL WATER TO BE USED AS:  
 1 Domestic  3 Feedlot  6 Oil field water supply  9 Dewatering  12 Other (Specify below)  
 2 Irrigation  4 Industrial  7 Lawn and garden only  10 Monitoring well  
 Was a chemical/bacteriological sample submitted to Department? Yes.....No.....; If yes, mo/day/yr sample was submitted  
 Water Well Disinfected?  Yes  No

5 TYPE OF BLANK CASING USED:  
 1 Steel  3 RMP (SR)  6 Asbestos-Cement  9 Other (specify below)  
 2 PVC  4 ABS  7 Fiberglass  8 Concrete tile  10 Asbestos-cement  
 Blank casing diameter 5 in. to 80 ft., Dia. in. to ft., Dia. in. to ft.  
 Casing height above land surface 2' in., weight Sch 40 lbs./ft. Wall thickness or gauge No.

TYPE OF SCREEN OR PERFORATION MATERIAL:  
 1 Steel  3 Stainless steel  5 Fiberglass  8 RMP (SR)  11 Other (specify)  
 2 Brass  4 Galvanized steel  6 Concrete tile  9 ABS  12 None used (open hole)  
 SCREEN OR PERFORATION OPENINGS ARE: 31/1000's  
 1 Continuous slot  3 Mill slot  5 Gauzed wrapped  8 Saw cut  11 None (open hole)  
 2 Louvered shutter  4 Key punched  6 Wire wrapped  9 Drilled holes

SCREEN-PERFORATED INTERVALS: From 80' ft. to 100' ft., From ft. to ft.  
 From ft. to ft., From ft. to ft.  
 GRAVEL PACK INTERVALS: From 20' ft. to 100' ft., From ft. to ft.  
 From ft. to ft., From ft. to ft.

6 GROUT MATERIAL:  1 Neat cement  2 Cement grout  3 Bentonite  4 Other  
 Grout Intervals: From 0 ft. to 20 ft., From ft. to ft., From ft. to ft.

What is the nearest source of possible contamination:  
 1 Septic tank  4 Lateral lines  7 Pit privy  10 Livestock pens  14 Abandoned water well  
 2 Sewer lines  5 Cess pool  8 Sewage lagoon  11 Fuel storage  15 Oil well/Gas well  
 3 Watertight sewer lines  6 Seepage pit  9 Feedyard  12 Fertilizer storage  16 Other (specify below)  
 13 Insecticide storage  
 Direction from well? EAST  
 How many feet? 80'

FROM	TO	LITHOLOGIC LOG	FROM	TO	PLUGGING INTERVALS
0	15	Brown Clay			
15	22	Yellow Clay			
22	23	Grey shale			
23	35	Brown Clay			
35	45	Rock			
45	66	Grey shale			
66	77	Rock			
77	96	Brown shale			
96	100	Blue shale			

7 CONTRACTOR'S OR LANDOWNER'S CERTIFICATION: This water well was  (1) constructed,  (2) reconstructed, or  (3) plugged under my jurisdiction and was completed on (mo/day/year) 9/14/88 and this record is true to the best of my knowledge and belief. Kansas Water Well Contractor's License No. 451 This Water Well Record was completed on (mo/day/yr) 10/9/88 under the business name of Haldeman Well Drilling by (signature) Craig Haldeman CWP/P.E.

OFFICE USE ONLY  
T  
R  
EW  
SEC.  
1/4  
1/4  
1/4