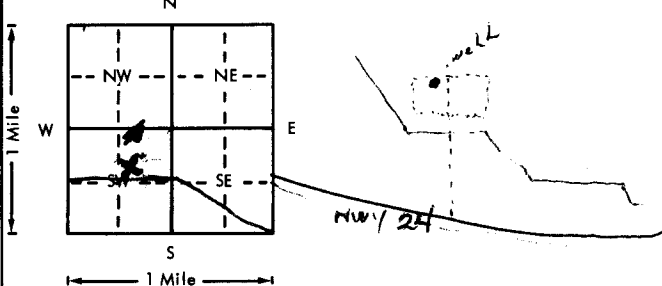


1-17-77

USE TYPEWRITER OR BALL POINT PEN-PRESS FIRMLY, PRINT CLEARLY.

WATER WELL RECORD
KSA 82a-1201-1215

Kansas Department of Health and Environment-Division of Environment
(Water well Contractors)
Topeka, Kansas 66620

1. Location of well:		County: Riley	Fraction: SW 1/4 NE 1/4 SW 1/4	Section number: 22	Township number: T 9	Range number: (S) (R) 7 (EW)
2. Distance and direction from nearest town or city: Street address of well location if in city: 3 miles N-2 west of MANHATTAN, KS on U.S. 24			3. Owner of well: Ed Doyle - Little Service Co. Inc R.R. or street: R.R. 4 City, state, zip code: Manhattan Kansas.			
4. Locate with "X" in section below: Sketch map: 			6. Bore hole dia. 8 in. Completion date 1-17-77 Well depth 100 ft.			
5. Type and color of material			From		To	
Mumbo			1		18	
yellow rock			18		24	
red clay			24		30	
Yellow rock			30		34	
green shale			34		36	
yellow rock			36		40	
red clay			40		48	
yellow rock (water) some			48		50	
tan clay			50		58	
yellow rock.			58		63	
green shale			63		72	
yellow rock (water) most			72		75	
gray shale			75		80	
gray rock			80		83	
gray shale.			83		90	
gray rock			90		94	
18. Elevation:		19. Remarks: Blue shale.		94-100		
Topography: Hill Slope Upland Valley			20. Water well contractor's certification: This well was drilled under my jurisdiction and this report is true to the best of my knowledge and belief. Ray Enslin Well Drilling 2024 Business name: Ray Enslin Well Drilling 2024 License No. 28 #6 Address: 28 #6 MANHATTAN, KS. 66502 Signed: Ray Enslin Date: 10-9-78 Authorized representative			

T 9 R 70 W 22 SW NE SW
1/4 1/4 1/4 1/4

Forward the white, blue and pink copies to the Department of Health and Environment

Form WWC-5