USE TYPEWRITER OR BALL POINT PEN-PRESS FIRMLY, PRINT CLEARLY.

WATER WELL RECORD
KSA 82a-1201-1215

Kansas Department of Health and Environment-Division of Environment
(Water well Contractors)
Topeka, Kansas 66620

1. Location of well:	County	Fraction	Section number	Township number	Range number
	Riley	SW 1/4 SW 1/4 NE 1/4	23	T 9 S	R 7 E/W

2. Distance and direction from nearest town or city: 4 N of
Street address of well location if in city: MANHATTAN

3. Owner of well: Duane Gilliam
R.R. or street: Herman Kastner } Lakewood
City, state, zip code: Manhattan, Ks 66502

4. Locate with "X" in section below:

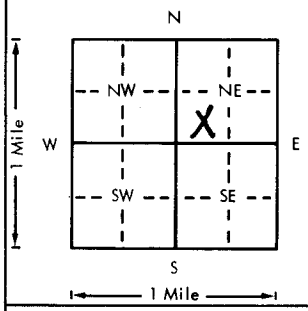

Sketch map:

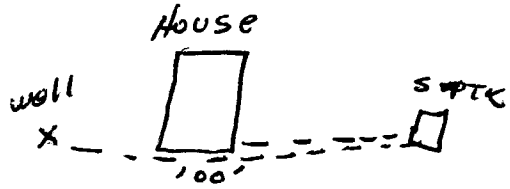

6. Bore hole dia. 8 in. Completion date
Well depth 235 ft. 4-17-79

7. __ Cable tool ✓ Rotary __ Driven __ Dug
__ Hollow rod __ Jetted __ Bored __ Reverse rotary

8. Use: ✓ Domestic __ Public supply __ Industry
__ Irrigation __ Air conditioning __ Stock
__ Lawn __ Oil field water __ Other

9. Casing: Material PVC Height: Above (circled) or below
Threaded ___ Welded ___ Surface 36 in.
RMP ___ PVC 9L Weight 2.87 lbs./ft.
Dia. 5 in. to 235 ft. depth Wall Thickness: inches or
Dia. ___ in. to ___ ft. depth gage No. 1250

10. Screen: Manufacturer's name Pumpco mpI
Type PVC Dia. 5"
Slot/gauze .060 Length
Set between 158 ft. and 235 ft.
___ ft. and ___ ft.
Gravel pack? ✓ Size range of material 1/4 x 1/8

11. Static water level: mo./day/yr.
195 ft. below land surface Date 4-17-79

12. Pumping level below land surfaces:
___ ft. after ___ hrs. pumping ___ g.p.m.
___ ft. after ___ hrs. pumping ___ g.p.m.
Estimated maximum yield 40 AT 205 g.p.m.

13. Water sample submitted: mo./day/yr.
__ Yes ✓ No Date

14. Well head completion: CAP
__ Pitless adapter 36 Inches above grade

15. Well grouted? ✓
With: ✓ Neat cement __ Bentonite __ Concrete
Depth: From 0 ft. to 10 ft.

16. Nearest source of possible contamination:
ft. 100 Direction E Type Septic
Well disinfected upon completion? ✓ Yes __ No

17. Pump: ✓ Not installed
Manufacturer's name
Model number HP Volts
Length of drop pipe ft. capacity g.p.m.
Type:
__ Submersible __ Turbine
__ Jet __ Reciprocating
__ Centrifugal __ Other

5. Type and color of material	From	To
Shale, yellow, grey	0	35
Limestone, yellow, shaley	35	49
Shale, yellow, Red, grey	49	83
Limestone, brown	83	89
Shale, grey, yellow, red	89	160
Shaley Limestone, brown	160	175
Shale, red, blk.	175	203
Limestone, yellow, water bearing	203	205
Shale, grey	205	235

(Use a second sheet if needed)

18. Elevation:

Topography:
✓ Hill
__ Slope
__ Upland
__ Valley

19. Remarks:
Owner to install SHS

20. Water well contractor's certification:
This well was drilled under my jurisdiction and this report is true to the best of my knowledge and belief.
Business name Stradac Drlg Co Inc License No. 182
Address RT 1 Holton, Ks
Signed Dale Ashcraft Date 4-19-79
Authorized representative

T 9 R 7 E/W Sec 23 1/4 SW 1/4 SW 1/4 NE 1/4

Forward the white, blue and pink copies to the Department of Health and Environment

Form WWC-5

M1-1023