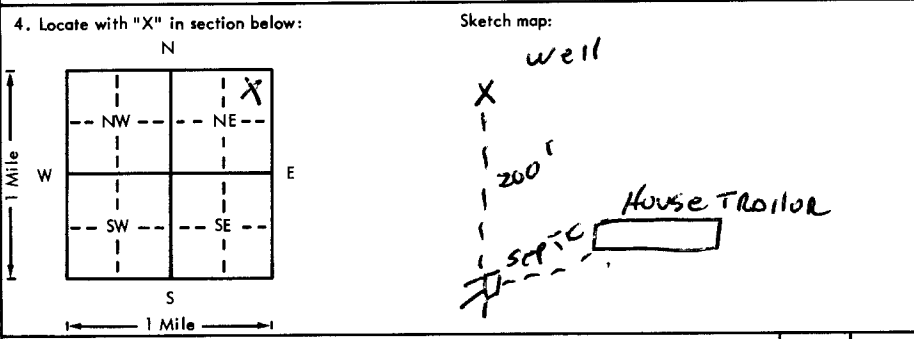


USE TYPEWRITER OR BALL POINT PEN-PRESS FIRMLY, PRINT CLEARLY.

WATER WELL RECORD  
KSA 82a-1201-1215

Kansas Department of Health and Environment-Division of Environment  
(Water well Contractors)  
Topeka, Kansas 66620

1. Location of well: County <u>Riley</u> Fraction <u>NE 1/4 NE 1/4 NE 1/4</u> Section number <u>28</u> Township number <u>T 9 S R 7 E/W</u> Range number	
2. Distance and direction from nearest town or city: <u>2.5 NW OF MANHATTAN, KS.</u> Street address of well location if in city: <u>MANHATTAN, KS.</u>	
3. Owner of well: <u>GARY HADLE</u> R.R. or street: <u>2138 PATRICIA</u> City, state, zip code: <u>MANHATTAN, KS</u>	
4. Locate with "X" in section below: Sketch map: 	
5. Type and color of material	
6. Bore hole dia. <u>8</u> in. Completion date <u>8-29-77</u> Well depth <u>200</u> ft.	
7. <input type="checkbox"/> Cable tool <input checked="" type="checkbox"/> Rotary <input type="checkbox"/> Driven <input type="checkbox"/> Dug <input type="checkbox"/> Hollow rod <input type="checkbox"/> Jetted <input type="checkbox"/> Bored <input type="checkbox"/> Reverse rotary	
8. Use: <input checked="" type="checkbox"/> Domestic <input type="checkbox"/> Public supply <input type="checkbox"/> Industry <input type="checkbox"/> Irrigation <input type="checkbox"/> Air conditioning <input type="checkbox"/> Stock <input type="checkbox"/> Lawn <input type="checkbox"/> Oil field water <input type="checkbox"/> Other	
9. Casing: Material <u>PVC</u> Height <u>(Above)</u> or below Threading <u>Welded</u> Surface <u>29</u> in. RMP <u>PVC 9L</u> Weight <u>2.84</u> lbs./ft. Dia. <u>5</u> in. to <u>200</u> ft. depth Wall Thickness: inches or Dia. <u>in.</u> to <u>ft.</u> depth gage No. <u>1258</u>	
10. Screen: Manufacturer's name <u>Pumpco MDI</u> Type <u>PVC</u> Dia. <u>5</u> (S) / gauze <u>dash</u> Length <u>40</u> Set between <u>80</u> ft. and <u>100</u> ft. <u>160</u> ft. and <u>180</u> ft. Gravel pack? <u>No</u> Size range of material <u>1/4 x 1/8</u>	
11. Static water level: <u>95</u> ft. below land surface Date <u>8-29-77</u> mo./day/yr.	
12. Pumping level below land surfaces: <u>    </u> ft. after <u>    </u> hrs. pumping <u>    </u> g.p.m. <u>    </u> ft. after <u>    </u> hrs. pumping <u>    </u> g.p.m. Estimated maximum yield <u>1/2</u> g.p.m.	
13. Water sample submitted: <u>    </u> mo./day/yr. Yes <input type="checkbox"/> No <input checked="" type="checkbox"/> Date <u>    </u>	
14. Well head completion: <u>CAP</u> Pitless adapter <u>29</u> Inches above grade	
15. Well grouted? <input checked="" type="checkbox"/> With: <input checked="" type="checkbox"/> Neat cement <input type="checkbox"/> Bentonite <input type="checkbox"/> Concrete Depth: From <u>5</u> ft. to <u>15</u> ft.	
16. Nearest source of possible contamination: ft. <u>200</u> Direction <u>S</u> Type <u>SEPTIC</u> Well disinfected upon completion? <input checked="" type="checkbox"/> Yes <input type="checkbox"/> No	
17. Pump: <input checked="" type="checkbox"/> Not installed Manufacturer's name <u>    </u> HP <u>    </u> Volts <u>    </u> Length of drop pipe <u>    </u> ft. capacity <u>    </u> g.p.m. Type: <input type="checkbox"/> Submersible <input type="checkbox"/> Turbine <input type="checkbox"/> Jet <input type="checkbox"/> Reciprocating <input type="checkbox"/> Centrifugal <input type="checkbox"/> Other	
(Use a second sheet if needed)	
18. Elevation: Topography: <input checked="" type="checkbox"/> Hill <input type="checkbox"/> Slope <input type="checkbox"/> Upland <input type="checkbox"/> Valley	19. Remarks: <u>OWNER TO INSTAL SLAB</u>
20. Water well contractor's certification: This well was drilled under my jurisdiction and this report is true to the best of my knowledge and belief. <u>Strader Dalg Co Inc</u> License No. <u>182</u> Business name <u>Holtan, KS</u> Address <u>    </u> Signed <u>Dale Baker</u> Date <u>8-25-77</u> Authorized representative	


Forward the white, blue and pink copies to the Department of Health and Environment

Form WWC-5