


1 LOCATION OF WATER WELL: Fraction SE 1/4 SE 1/4 SE 1/4 Section Number 31 Township Number T 9 S Range Number R 7 EW
 County: Riley

Distance and direction from nearest town or city street address of well if located within city? From Manhattan 60 2 miles west on Anderson to west 60th Ave. + 60 3/4 rds of a mile north + west 1/4 mile on Flinstone circle

2 WATER WELL OWNER: Arden Lochter
 RR#, St. Address, Box #: 2829 West 60th Ave. Board of Agriculture, Division of Water Resources
 City, State, ZIP Code: Manhattan, KS 66502 Application Number:

3 LOCATE WELL'S LOCATION WITH AN "X" IN SECTION BOX:

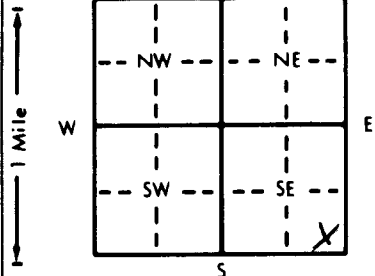

4 DEPTH OF COMPLETED WELL: 200' ft. ELEVATION:
 Depth(s) Groundwater Encountered 1. 9.2 ft. 2. ft. 3. ft.
 WELL'S STATIC WATER LEVEL: 9.0 ft. below land surface measured on mo/day/yr
 Pump test data: Well water was ft. after hours pumping gpm
 Est. Yield 3 gpm: Well water was ft. after hours pumping gpm
 Bore Hole Diameter: 9 in. to 200 ft., and in. to ft.
 WELL WATER TO BE USED AS:
 1 Domestic 3 Feedlot 6 Oil field water supply 9 Dewatering 12 Other (Specify below)
 2 Irrigation 4 Industrial 7 Lawn and garden only 10 Monitoring well
 Was a chemical/bacteriological sample submitted to Department? Yes No: If yes, mo/day/yr sample was submitted
 Water Well Disinfected? Yes No

5 TYPE OF BLANK CASING USED:
 1 Steel 3 RMP (SR) 6 Asbestos-Cement 9 Other (specify below) Welded
 2 PVC 4 ABS 7 Fiberglass Threaded
 Blank casing diameter: 5 in. to 180 ft., Dia. in. to ft., Dia. in. to ft.
 Casing height above land surface: 2' in., weight Sch 40 lbs./ft. Wall thickness or gauge No.

TYPE OF SCREEN OR PERFORATION MATERIAL:
 1 Steel 3 Stainless steel 5 Fiberglass 8 RMP (SR) 10 Asbestos-cement
 2 Brass 4 Galvanized steel 6 Concrete tile 9 ABS 11 Other (specify)
 12 None used (open hole)

SCREEN OR PERFORATION OPENINGS ARE:
 1 Continuous slot 3 Mill slot 25 / 1,000's 5 Gauzed wrapped 8 Saw cut 11 None (open hole)
 2 Louvered shutter 4 Key punched 6 Wire wrapped 9 Drilled holes
 7 Torch cut 10 Other (specify)

SCREEN-PERFORATED INTERVALS: From 180 ft. to 200 ft., From ft. to ft.
 GRAVEL PACK INTERVALS: From 25 ft. to 200 ft., From ft. to ft.

6 GROUT MATERIAL: 1 Neat cement 2 Cement grout 3 Bentonite 4 Other
 Grout intervals: From 0 ft. to 25 ft., From ft. to ft., From ft. to ft.

What is the nearest source of possible contamination:
 1 Septic tank 4 Lateral lines 7 Pit privy 10 Livestock pens 14 Abandoned water well
 2 Sewer lines 5 Cess pool 8 Sewage lagoon 11 Fuel storage 15 Oil well/Gas well
 3 Watertight sewer lines 6 Seepage pit 9 Feedyard 12 Fertilizer storage 16 Other (specify below)

Direction from well? How many feet?

FROM	TO	LITHOLOGIC LOG	FROM	TO	PLUGGING INTERVALS
0	1	Top Soil	161	163	Limestone
1	12	Brown Clay	163	176	Brown shale
12	25	Grey shale	176	188	Limestone
25	27	Limestone	188	200	Grey shale
27	39	Yellow shale			
39	58	Grey shale			
58	65	Limestone			
65	74	Grey shale			
74	92	Brown shale			
92	95	Limestone (with)			
95	128	Brown shale			
128	133	Limestone			
133	150	Brown shale			
150	152	Limestone			
152	161	Tan shale			

7 CONTRACTOR'S OR LANDOWNER'S CERTIFICATION: This water well was (1) constructed, (2) reconstructed, or (3) plugged under my jurisdiction and was completed on (mo/day/year) 2/21/92 and this record is true to the best of my knowledge and belief. Kansas Water Well Contractor's License No. 451 This Water Well Record was completed on (mo/day/yr) 3/11/92 under the business name of Holdeman Well Drilling by (signature) Craig H. CupPE

OFFICE USE ONLY
T
R
EW
SEC.
1/4
1/4
1/4