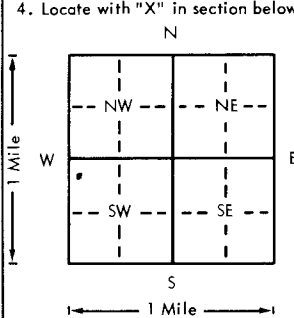


USE TYPEWRITER OR BALL POINT PEN—PRESS FIRMLY, PRINT CLEARLY.

WATER WELL RECORD
KSA 82a-1201-1215

Kansas Department of Health and Environment—Division of Environment
(Water well Contractors)
Topeka, Kansas 66620

1. Location of well: County RILEY		Fraction NW 1/4 NW 1/4 SW 1/4		Section number 36		Township number T 9 S R 7 E/W		Range number	
2. Distance and direction from nearest town or city: Street address of well location if in city: 2 miles North of K.S.U. MANHATTAN, KS				3. Owner of well: J.D. Schnachenburg R.R. or street: Rogers Addition City, state, zip code: MANHATTAN, KS.					
4. Locate with "X" in section below: 				Sketch map:		6. Bore hole dia. 8 in. Completion date 10/31/80 Well depth 158 ft.			
						7. <input checked="" type="checkbox"/> Cable tool <input type="checkbox"/> Rotary <input type="checkbox"/> Driven <input type="checkbox"/> Dug <input type="checkbox"/> Hollow rod <input type="checkbox"/> Jetted <input type="checkbox"/> Bored <input type="checkbox"/> Reverse rotary			
						8. Use: <input checked="" type="checkbox"/> Domestic <input type="checkbox"/> Public supply <input type="checkbox"/> Industry <input type="checkbox"/> Irrigation <input type="checkbox"/> Air conditioning <input type="checkbox"/> Stock <input type="checkbox"/> Lawn <input type="checkbox"/> Oil field water <input type="checkbox"/> Other			
						9. Casing: Material PVC Height: Above or below Threaded <input type="checkbox"/> Welded <input type="checkbox"/> Surface 24 in. RMP <input type="checkbox"/> PVC 5440 Weight 258 lbs./ft. Dia. 5 in. to 158 ft. depth Wall Thickness: inches or Dia. <input type="checkbox"/> in. to <input type="checkbox"/> ft. depth gage No. 256-14			
5. Type and color of material				From	To	10. Screen: Manufacturer's name PLUM CO SUPPLY Type PVC Dia. 5" Slot/gauze 060 Length 10' Set between 138 ft. and 148 ft. Gravel pack? YES Size range of material PEA			
Rocky Top Soil				1	8	11. Static water level: <input type="checkbox"/> mo./day/yr. 136 ft. below land surface Date 10/31/80			
Yellowish Green Shale				8	29	12. Pumping level below land surfaces: ____ ft. after ____ hrs. pumping ____ g.p.m. ____ ft. after ____ hrs. pumping ____ g.p.m. Estimated maximum yield ____ 11-12 g.p.m.			
Yellow Rock				29	34	13. Water sample submitted: ____ mo./day/yr. <input type="checkbox"/> Yes <input checked="" type="checkbox"/> No Date ____			
Yellow & Blue Shale				34	55	14. Well head completion: CAPPED <input checked="" type="checkbox"/> Pitless adapter 24 Inches above grade			
Yellow Rock				55	62	15. Well grouted? YES With: <input checked="" type="checkbox"/> Neat cement <input type="checkbox"/> Bentonite <input type="checkbox"/> Concrete Depth: From 3 ft. to 18 ft.			
Redish Clay				62	95	16. Nearest source of possible contamination: ft. 100+ Direction SE Type TANK Well disinfected upon completion? <input checked="" type="checkbox"/> Yes <input type="checkbox"/> No			
Yellow Rock				95	101	17. Pump: <input checked="" type="checkbox"/> Not installed Manufacturer's name Dempster Model number ____ HP 1 Volt 220 Length of drop pipe 154 ft. capacity 10 g.p.m. Type: <input checked="" type="checkbox"/> Submersible <input type="checkbox"/> Turbine <input type="checkbox"/> Jet <input type="checkbox"/> Reciprocating <input type="checkbox"/> Centrifugal <input type="checkbox"/> Other			
Yellow Clay				101	112				
Green Shale				112	119				
Yellow Rock				119	124				
GRAY Rock				124	132				
Yellow Clay				132	138				
Yellow Rock (water)				138	140				
GREEN CLAY				140	153				
GRAY SHALE				153	158				
(Use a second sheet if needed)									
18. Elevation:		19. Remarks:		20. Water well contractor's certification: This well was drilled under my jurisdiction and this report is true to the best of my knowledge and belief. W. Easley Well Drilling, 202 Business address: 146 MANHATTAN, KS 66502 License No. ____ Address: Day 2 Signed: Day 2 Date 10-31-80 Authorized representative					

T-9
R-2
W-36
Sec-1/4 NW 1/4 SW

Forward the white, blue and pink copies to the Department of Health and Environment

Form WWC-5