


1] LOCATION OF WATER WELL: County: Riley Fraction: MM 1/4 NE 1/4 NW 1/4 Section Number: 25 Township Number: T 9 S Range Number: R 7 **(EW)**

Distance and direction from nearest town or city street address of well if located within city?
5321 Lakeside Blvd., Manhattan, Kansas

2] WATER WELL OWNER: KDHE
 RR#, St. Address, Box # : Forbes Field, Bldg 740 Board of Agriculture, Division of Water Resource
 City, State, ZIP Code : Topeka, Kansas 66620-0001 Application Number:

3] LOCATE WELL'S LOCATION WITH AN "X" IN SECTION BOX:

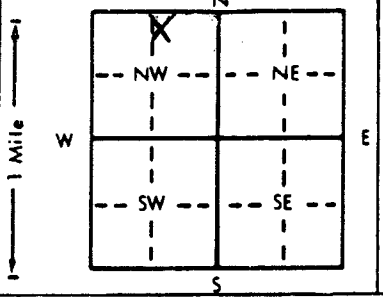

4] DEPTH OF COMPLETED WELL: 70 ft. ELEVATION: ft.
 Depth(s) Groundwater Encountered 1. NA ft. 2. ft. 3. ft.
 WELL'S STATIC WATER LEVEL ft. below land surface measured on mo/day/yr
 Pump test data: Well water was ft. after hours pumping gpm
 Est. Yield gpm: Well water was ft. after hours pumping gpm
 Bore Hole Diameter: 8 in. to 70.5 ft., and in. to ft.
 WELL WATER TO BE USED AS: 5 Public water supply 8 Air conditioning 11 Injection well
 1 Domestic 3 Feedlot 6 Oil field water supply 9 Dewatering 12 Other (Specify below)
 2 Irrigation 4 Industrial 7 Lawn and garden only **(10)** Monitoring well
 Was a chemical/bacteriological sample submitted to Department? Yes..... No. **X**..... If yes, mo/day/yr sample was submitted
 Water Well Disinfected? Yes No **X**

5] TYPE OF BLANK CASING USED: 1 Steel 3 RMP (SR) 5 Wrought iron 8 Concrete tile CASING JOINTS: Glued Clamped
(2) PVC 4 ABS 7 Fiberglass 9 Other (specify below) Welded
 Blank casing diameter 2 in. to 55 ft., Dia in. to ft., Dia in. to ft.
 Casing height above land surface 36 in., weight lbs./ft. Wall thickness or gauge No. sch. 40
 TYPE OF SCREEN OR PERFORATION MATERIAL: **(7)** PVC 10 Asbestos-cement
 1 Steel 3 Stainless steel 5 Fiberglass 8 RMP (SR) 11 Other (specify)
 2 Brass 4 Galvanized steel 6 Concrete tile 9 ABS 12 None used (open hole)
 SCREEN OR PERFORATION OPENINGS ARE: 5 Gauzed wrapped 8 Saw cut 11 None (open hole)
 1 Continuous slot **(3)** Mill slot 6 Wire wrapped 9 Drilled holes
 2 Louvered shutter 4 Key punched 7 Torch cut 10 Other (specify)
 SCREEN-PERFORATED INTERVALS: From 55.5 ft. to 70.5 ft., From ft. to ft.
 GRAVEL PACK INTERVALS: From 52 ft. to 73 ft., From ft. to ft.

6] GROUT MATERIAL: 1 Neat cement **(2)** Cement grout **(3)** Bentonite 4 Other
 Grout Intervals: From 0 ft. to 47 ft., From 47 ft. to 52 ft., From ft. to ft.
 What is the nearest source of possible contamination:
 1 Septic tank 4 Lateral lines 7 Pit privy **(11)** Fuel storage 10 Livestock pens 14 Abandoned water well
 2 Sewer lines 5 Cess pool 8 Sewage lagoon 12 Fertilizer storage 15 Oil well/Gas well
 3 Watertight sewer lines 6 Seepage pit 9 Feedyard 13 Insecticide storage 16 Other (specify below)
 Direction from well? West How many feet? 300

FROM	TO	LITHOLOGIC LOG	FROM	TO	PLUGGING INTERVALS
0	16	Clay - brown			
16	21	Limestone - tan			
21	26	Shale - green			
26	33	Interbedded limestone & shale			
33	36	Limestone - tan			
36	38	Shale - gray			
38	43	Limestone - tan			
43	44	Shale - gray			
44	48	Limestone - tan			
48	53	Limey shale - gray			
53	61	Shale - green gray			
61	63	Limestone - tan			
63	68	Shale - green			
68	70.5	Limestone - tan			

MW3 - Flushmount
 Don Taylor

7] CONTRACTOR'S OR LANDOWNER'S CERTIFICATION: This water well was **(1)** constructed, (2) reconstructed, or (3) plugged under my jurisdiction and was completed on (mo/day/year) 0-07-94 and this record is true to the best of my knowledge and belief. Kansas Water Well Contractor's License No. 527 This Water Well Record was completed on (mo/day/yr) 10-06-94 under the business name of GeoCore Services, Inc. by (signature) Dale A. Roll

INSTRUCTIONS: Use typewriter or ball point pen. PLEASE PRESS FIRMLY and PRINT clearly. Please fill in blanks, underline or circle the correct answers. Send top three copies to Kansas Department of Health and Environment, Bureau of Water, Topeka, Kansas 66620-0001. Telephone: 913-296-5545. Send one to WATER WELL OWNER and retain one for your records.