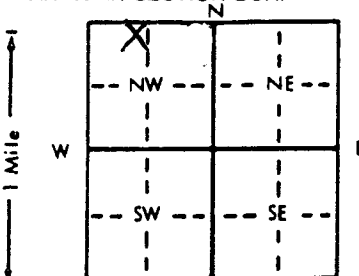


1 LOCATION OF WATER WELL: County: Riley Fraction: NE 1/4 NW 1/4 NW 1/4 Section Number: 25 Township Number: T 9 S Range Number: R 7 E

Distance and direction from nearest town or city street address of well if located within city?
532 Lakeside Blvd., Manhattan, Kansas

2 WATER WELL OWNER: KDHE
 RR#, St. Address, Box # : Forbes Field, Bldg 740 Board of Agriculture, Division of Water Resources
 City, State, ZIP Code : Topeka, Kansas 66620-0001 Application Number:

3 LOCATE WELL'S LOCATION WITH AN "X" IN SECTION BOX:


4 DEPTH OF COMPLETED WELL: 75 ft. ELEVATION:
 Depth(s) Groundwater Encountered 1. NA ft. 2. NA ft. 3. NA ft.
 WELL'S STATIC WATER LEVEL NA ft. below land surface measured on mo/day/yr
 Pump test data: Well water was NA ft. after NA hours pumping NA gpm
 Est. Yield NA gpm: Well water was NA ft. after NA hours pumping NA gpm
 Bore Hole Diameter: 8 in. to 75 ft., and NA in. to NA ft.
 WELL WATER TO BE USED AS:
 1 Domestic 2 Irrigation 3 Feedlot 4 Industrial 5 Public water supply 6 Oil field water supply 7 Lawn and garden only 8 Air conditioning 9 Dewatering 10 Monitoring well 11 Injection well 12 Other (Specify below)
 Was a chemical/bacteriological sample submitted to Department? Yes NA No X; If yes, mo/day/yr sample was submitted NA
 Water Well Disinfected? Yes NA No X

5 TYPE OF BLANK CASING USED:
 1 Steel 2 PVC 3 RMP (SR) 4 ABS 5 Wrought iron 6 Asbestos-Cement 7 Fiberglass 8 Concrete tile 9 Other (specify below) CASING JOINTS: Glued NA Clamped NA Welded NA Threaded X
 Blank casing diameter 2 in. to 45 ft., Dia NA in. to NA ft., Dia NA in. to NA ft.
 Casing height above land surface 36 in., weight NA lbs./ft. Wall thickness or gauge No. 40 sch.
 TYPE OF SCREEN OR PERFORATION MATERIAL:
 1 Steel 2 Brass 3 Stainless steel 4 Galvanized steel 5 Fiberglass 6 Concrete tile 7 PVC 8 RMP (SR) 9 ABS 10 Asbestos-cement 11 Other (specify) 12 None used (open hole)
 SCREEN OR PERFORATION OPENINGS ARE:
 1 Continuous slot 2 Louvered shutter 3 Mill slot 4 Key punched 5 Gauzed wrapped 6 Wire wrapped 7 Torch cut 8 Saw cut 9 Drilled holes 11 None (open hole) 10 Other (specify)
 SCREEN-PERFORATED INTERVALS: From 45 ft. to 75 ft., From NA ft. to NA ft., From NA ft. to NA ft.
 GRAVEL PACK INTERVALS: From 43 ft. to 75 ft., From NA ft. to NA ft., From NA ft. to NA ft.

6 GROUT MATERIAL: 1 Neat cement 2 Cement grout 3 Bentonite 4 Other
 Grout intervals: From 0 ft. to 38 ft., From 38 ft. to 43 ft., From NA ft. to NA ft.
 What is the nearest source of possible contamination:
 1 Septic tank 2 Sewer lines 3 Watertight sewer lines 4 Lateral lines 5 Cess pool 6 Seepage pit 7 Pit privy 8 Sewage lagoon 9 Feedyard 10 Livestock pens 11 Fuel storage 12 Fertilizer storage 13 Insecticide storage 14 Abandoned water well 15 Oil well/Gas well 16 Other (specify below)
 Direction from well? North - Northeast How many feet? 300

FROM	TO	LITHOLOGIC LOG	FROM	TO	PLUGGING INTERVALS
0	2	Clay - yellow brown	50.5	58	Interbedded Limestone and Shale
2	8	shale - yellow brown	58	65	Shale - gray
8	12.5	Limestone - tan	65	67	Limestone - tan
12.5	17.5	Interbedded limestone & Shale	67	68	Shale - gray
17.5	22	Limestone - green gray	68	72	Limestone
22	24	Shale - maroon	72	73	Shale - light brown
24	25	Shale - green	73	75	Limestone - tan
25	29	Limestone - green gray			
29	31.5	Shale - yellow			
31.5	34.5	Limestone - gray tan			
34.5	37	Shale - gray			
37	38	Limey shale - maroon			MW4 - Flushmount cover
38	40.5	Shale - green			
40.5	42	Limestone - green			
42	50.5	Limestone - tan			

7 CONTRACTOR'S OR LANDOWNER'S CERTIFICATION: This water well was (1) constructed, (2) reconstructed, or (3) plugged under my jurisdiction and was completed on (mo/day/year) 09-07-94 and this record is true to the best of my knowledge and belief. Kansas Water Well Contractor's License No. 527 This Water Well Record was completed on (mo/day/yr) 10-06-94 under the business name of GeoCore Services, Inc. by (signature) Paul A. Bell