


1 LOCATION OF WATER WELL: County: Riley Fraction: SE 1/4 SW 1/4 SW 1/4 Section Number: 24 Township Number: T 9 S Range Number: R 7 EW

Distance and direction from nearest town or city street address of well if located within city?  
532 Lakeside Blvd., Manhattan, Kansas

2 WATER WELL OWNER: KDHE  
 RR#, St. Address, Box #: Forbes Field, Bldg 740 Board of Agriculture, Division of Water Resource  
 City, State, ZIP Code: Topeka, Kansas 66620-0001 Application Number:

3 LOCATE WELL'S LOCATION WITH AN "X" IN SECTION BOX:

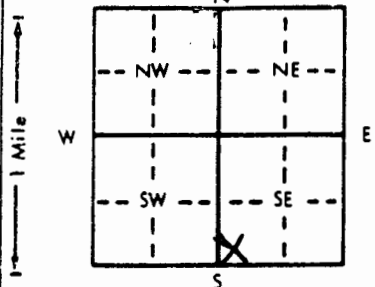

4 DEPTH OF COMPLETED WELL: 30 ft. ELEVATION:

Depth(s) Groundwater Encountered 1. NA ft. 2. NA ft. 3. NA ft.  
 WELL'S STATIC WATER LEVEL NA ft. below land surface measured on mo/day/yr  
 Pump test data: Well water was NA ft. after NA hours pumping NA gpm  
 Est. Yield NA gpm: Well water was NA ft. after NA hours pumping NA gpm  
 Bore Hole Diameter: 8 in. to 30 in. and NA in. to NA in.  
 WELL WATER TO BE USED AS:  
 1 Domestic 3 Feedlot 6 Oil field water supply 8 Air conditioning 11 Injection well  
 2 Irrigation 4 Industrial 7 Lawn and garden only 10 Monitoring well 12 Other (Specify below)  
 Was a chemical/bacteriological sample submitted to Department? Yes NA No X; If yes, mo/day/yr sample was submitted  
 Water Well Disinfected? Yes NA No X

5 TYPE OF BLANK CASING USED: 1 Steel 3 RMP (SR) 5 Wrought iron 8 Concrete tile CASING JOINTS: Glued Clamped  
 2 PVC 4 ABS 7 Fiberglass 9 Other (specify below) Welded  
 Threaded X

Blank casing diameter 2 in. to 10 in. Dia NA in. to NA in. Dia NA in. to NA in. Dia NA in. to NA in. Dia  
 Casing height above land surface 36 in., weight NA lbs./ft. Wall thickness or gauge No. sch. 40

TYPE OF SCREEN OR PERFORATION MATERIAL: 1 Steel 3 Stainless steel 5 Fiberglass 7 PVC 10 Asbestos-cement  
 2 Brass 4 Galvanized steel 6 Concrete tile 8 RMP (SR) 9 ABS 11 Other (specify)  
 12 None used (open hole)

SCREEN OR PERFORATION OPENINGS ARE: 1 Continuous slot 2 Louvered shutter 3 Mill slot 4 Key punched 5 Gauzed wrapped 6 Wire wrapped 7 Torch cut 8 Saw cut 9 Drilled holes 11 None (open hole)  
 10 Other (specify)

SCREEN-PERFORATED INTERVALS: From 10 ft. to 30 ft., From NA ft. to NA ft., From NA ft. to NA ft.  
 GRAVEL PACK INTERVALS: From 8 ft. to 30 ft., From NA ft. to NA ft., From NA ft. to NA ft.

6 GROUT MATERIAL: 1 Neat cement 2 Cement grout 3 Bentonite 4 Other  
 Grout Intervals: From 0 ft. to 5 ft., From 5 ft. to 8 ft., From NA ft. to NA ft.

What is the nearest source of possible contamination:  
 1 Septic tank 4 Lateral lines 7 Pit privy 10 Livestock pens 11 Fuel storage 14 Abandoned water well  
 2 Sewer lines 5 Cess pool 8 Sewage lagoon 12 Fertilizer storage 15 Oil well/Gas well  
 3 Watertight sewer lines 6 Seepage pit 9 Feedyard 13 Insecticide storage 16 Other (specify below)  
 Direction from well? Southeast How many feet? 50

FROM	TO	LITHOLOGIC LOG	FROM	TO	PLUGGING INTERVALS
0	2.5	Clay - tan	29.5	30	Limestone - gray
2.5	6	Limestone - tan			
6	10.5	Shale - green gray			
10.5	13	Limestone - tan			
13	14	Shale gray			
14	15.5	Limestone - tan			
15.5	18	Shale - green gray			
18	20	shale - gray			
20	20.5	Limestone - tan			
20.5	21	Shale - green			
21	25	Limestone - gray green			
25	26.5	Limestone - gray			
26.5	28	Limestone - tan			MW9 - Flushmount
28	28.5	Limestone - gray			
28.5	29.5	Shale - gray			

7 CONTRACTOR'S OR LANDOWNER'S CERTIFICATION: This water well was (1) constructed, (2) reconstructed, or (3) plugged under my jurisdiction and was completed on (mo/day/year) 09-13-94 and this record is true to the best of my knowledge and belief. Kansas Water Well Contractor's License No. 527 This Water Well Record was completed on (mo/day/yr) 10-06-94 under the business name of GeoCore Services, Inc. by (signature) Rob A. Holt

INSTRUCTIONS: Use typewriter or ball point pen. PLEASE PRESS FIRMLY and PRINT clearly. Please fill in blanks, underline or circle the correct answers. Send top three copies to Kansas Department of Health and Environment, Bureau of Water, Topeka, Kansas 66620-0001. Telephone: 913-296-5545. Send one to WATER WELL OWNER and retain one for your records.