


1 LOCATION OF WATER WELL: Fraction SW 1/4 NE 1/4 SE 1/4 Section Number 4 Township Number T 9 S Range Number R 7 E/W
 County: Riley

Distance and direction from nearest town or city street address of well if located within city?

5 Miles on Mill Cove Dr. off HYW. 77

2 WATER WELL OWNER: Joann Moyers
 RR#, St. Address, Box #: 7166 Mill Cove Dr. Board of Agriculture, Division of Water Resources
 City, State, ZIP Code: Manhattan, KS. 66502 Application Number:

3 LOCATE WELL'S LOCATION WITH AN "X" IN SECTION BOX: 4 DEPTH OF COMPLETED WELL: 195 ft. ELEVATION:ft.
 Depth(s) Groundwater Encountered 1.ft. 2.ft. 3.ft.
 WELL'S STATIC WATER LEVEL: 140' ft. below land surface measured on mo/day/yr 9/28/94
 Pump test data: Well water wasft. after hours pumping gpm
 Est. Yield .10 gpm: Well water wasft. after hours pumping gpm
 Bore Hole Diameter: 8 in. to 202' ft., andin. toft.
 WELL WATER TO BE USED AS: 5 Public water supply 8 Air conditioning 11 Injection well
 1 Domestic 3 Feedlot 6 Oil field water supply 9 Dewatering 12 Other (Specify below)
 2 Irrigation 4 Industrial 7 Lawn and garden only 10 Monitoring well
 Was a chemical/bacteriological sample submitted to Department? Yes.....No.....*
 If yes, mo/day/yr sample was submitted Water Well Disinfected? Yes * No

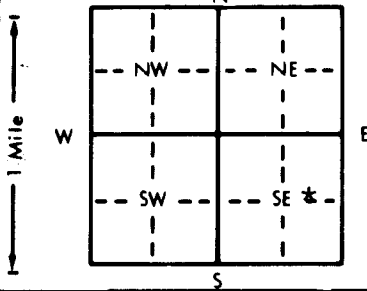

5 TYPE OF BLANK CASING USED: 5 Wrought iron 8 Concrete tile CASING JOINTS: Glued * Clamped
 1 Steel 3 RMP (SR) 6 Asbestos-Cement 9 Other (specify below) Welded
 2 PVC 4 ABS 7 Fiberglass Threaded
 Blank casing diameter 5 in. to 135 ft., Dia.in. toft., Dia.in. toft.
 Casing height above land surface: 18 in., weight 200 lbs./ft. Wall thickness or gauge No.
 TYPE OF SCREEN OR PERFORATION MATERIAL: 7 PVC 10 Asbestos-cement
 1 Steel 3 Stainless steel 5 Fiberglass 8 RMP (SR) 11 Other (specify)
 2 Brass 4 Galvanized steel 6 Concrete tile 9 ABS 12 None used (open hole)
 SCREEN OR PERFORATION OPENINGS ARE: 5 Gauzed wrapped 8 Saw cut 11 None (open hole)
 1 Continuous slot 3 Mill slot 6 Wire wrapped 9 Drilled holes
 2 Louvered shutter 4 Key punched 7 Torch cut 10 Other (specify)
 SCREEN-PERFORATED INTERVALS: From 135' ft. to 155' ft., Fromft. toft.
 From 175 ft. to 195 ft., Fromft. toft.
 GRAVEL PACK INTERVALS: From 25 ft. to 195 ft., Fromft. toft.
 Fromft. toft., Fromft. toft.

6 GROUT MATERIAL: 1 Neat cement 2 Cement grout 3 Bentonite 4 Other
 Grout Intervals: From .25 ft. to 195 ft., Fromft. toft., Fromft. toft.
 What is the nearest source of possible contamination:
 1 Septic tank 4 Lateral lines 7 Pit privy 10 Livestock pens 14 Abandoned water well
 2 Sewer lines 5 Cess pool 8 Sewage lagoon 11 Fuel storage 15 Oil well/Gas well
 3 Watertight sewer lines 6 Seepage pit 9 Feedyard 12 Fertilizer storage 16 Other (specify below)
 13 Insecticide storage
 Direction from well? South How many feet? 20

FROM	TO	LITHOLOGIC LOG	FROM	TO	PLUGGING INTERVALS
0	4	Topsoil & Lime Rock			
4	8	Limestone			
8	9	Yellow Shale			
9	23	Tan Shale			
23	32	Limestone			
32	41	Tan Shale			
41	49	Red Shale			
49	98	Tan Shale			
98	102	Red Shale			
102	105	Limestone			
105	141	Gray Shale			
141	142	Cavern			
142	194	Limestone Gray Shale			
194	198	Limestone			
198	202	Gray Shale			

7 CONTRACTOR'S OR LANDOWNER'S CERTIFICATION: This water well was (1) constructed, (2) reconstructed, or (3) plugged under my jurisdiction and was completed on (mo/day/year) 9/28/94 and this record is true to the best of my knowledge and belief. Kansas Water Well Contractor's License No. 518 This Water Well Record was completed on (mo/day/yr) 10/8/94 under the business name of Blue Valley Drilling by (signature) Eric Stank

OFFICE USE ONLY
T
R
EW
SEC.
1/4
1/4
1/4