


1 LOCATION OF WATER WELL: County: Pottawatomie Fraction: NW 1/4 NW 1/4 NW 1/4 Section Number: 19 Township Number: T 9 S Range Number: R 8 E/W
Distance and direction from nearest town or city street address of well if located within city? From Manhattan Go North on 24 4 miles To Tuttle Creek Dam To River Pond Area

2 WATER WELL OWNER: Tuttle Creek State Park
RR#, St. Address, Box #: 5020-13 Tuttle Creek Blvd. Board of Agriculture, Division of Water Resources
City, State, ZIP Code: Manhattan, KS 66502 Application Number:

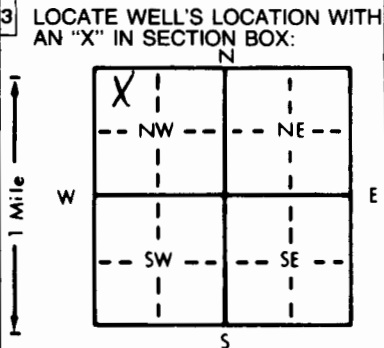

4 DEPTH OF COMPLETED WELL: 44 ft. ELEVATION:
Depth(s) Groundwater Encountered 1. 14 ft. 2. . . . ft. 3. . . . ft.
WELL'S STATIC WATER LEVEL: 14 ft. below land surface measured on mo/day/yr
Pump test data: Well water was ft. after hours pumping gpm
Est. Yield: 50 gpm Well water was ft. after hours pumping gpm
Bore Hole Diameter: 10 in. to 44 in. to ft. and in. to ft.
WELL WATER TO BE USED AS: 5 Public water supply 8 Air conditioning 11 Injection well
7 Domestic 3 Feedlot 6 Oil field water supply 9 Dewatering 12 Other (Specify below)
2 Irrigation 4 Industrial 7 Lawn and garden only 10 Monitoring well
Was a chemical/bacteriological sample submitted to Department? Yes No ; If yes, mo/day/yr sample was submitted
Water Well Disinfected? Yes No

5 TYPE OF BLANK CASING USED: 1 Steel 3 RMP (SR) 5 Wrought iron 8 Concrete tile CASING JOINTS: Glued Clamped
2 PVC 4 ABS 6 Asbestos-Cement 9 Other (specify below) Welded
Blank casing diameter: 5 in. to 24 in. Dia. . . . in. to ft., Dia. . . . in. to ft.
Casing height above land surface: 3 in., weight SAFE lbs./ft. Wall thickness or gauge No. . . .
TYPE OF SCREEN OR PERFORATION MATERIAL: 7 PVC 10 Asbestos-cement
1 Steel 3 Stainless steel 5 Fiberglass 8 RMP (SR) 11 Other (specify)
2 Brass 4 Galvanized steel 6 Concrete tile 9 ABS 12 None used (open hole)
SCREEN OR PERFORATION OPENINGS ARE: 3 Mill slot 10/1000 5 Gauzed wrapped 8 Saw cut 11 None (open hole)
1 Continuous slot 6 Wire wrapped 9 Drilled holes
2 Louvered shutter 4 Key punched 7 Torch cut 10 Other (specify)
SCREEN-PERFORATED INTERVALS: From 24 ft. to 44 ft., From ft. to ft.
GRAVEL PACK INTERVALS: From 20 ft. to 44 ft., From ft. to ft.

6 GROUT MATERIAL: 1 Neat cement 2 Cement grout 3 Bentonite 4 Other
Grout Intervals: From 0 ft. to 20 ft., From ft. to ft.
What is the nearest source of possible contamination:
1 Septic tank 4 Lateral lines None Close 7 Pit privy 10 Livestock pens 14 Abandoned water well
2 Sewer lines 5 Cess pool 8 Sewage lagoon 12 Fertilizer storage 15 Oil well/Gas well
3 Watertight sewer lines 6 Seepage pit 9 Feedyard 13 Insecticide storage 16 Other (specify below)
Direction from well? How many feet?

FROM		TO		LITHOLOGIC LOG	FROM		TO		PLUGGING INTERVALS
0	2			Top Soil					
2	26			Sandy Brown Clay (NOTED)					
26	44			Coarse Sand					

7 CONTRACTOR'S OR LANDOWNER'S CERTIFICATION: This water well was (1) constructed (2) reconstructed, or (3) plugged under my jurisdiction and was completed on (mo/day/year) 10/17/95 and this record is true to the best of my knowledge and belief. Kansas Water Well Contractor's License No. 451 This Water Well Record was completed on (mo/day/yr) 11/3/95
under the business name of Holdman Well Drilling by (signature) Clayton Cap/PE

INSTRUCTIONS: Use typewriter or ball point pen. PLEASE PRESS FIRMLY and PRINT clearly. Please fill in blanks, underline or circle the correct answers. Send top three copies to Kansas Department of Health and Environment, Bureau of Water, Topeka, Kansas 66620-0001. Telephone: 913-296-5545. Send one to WATER WELL OWNER and retain one for your records.