

CORRECTION(S) TO WATER WELL RECORD (WWC-5)

(to rectify lacking or incorrect information)

County: Pottawatomie

Location listed as:

Location changed to:

Section-Township-Range: \_\_\_\_\_

25-9S-8E

Fraction (  $\frac{1}{4}$   $\frac{1}{4}$   $\frac{1}{4}$ ): \_\_\_\_\_

SE NE NW

Other changes: Initial statements: County listed as Riley

Changed to: Pottawatomie Co.

Comments: \_\_\_\_\_


verification method: Map on internet + directions from Manhattan on Pottawatomie Co. map.


initials: EP date: 10/3/2005

1 LOCATION OF WATER WELL: County: Riley Fraction: SE 1/4 NE 1/4 NW 1/4 Section Number: 25 Township Number: T 9 S Range Number: R 8 E

Distance and direction from nearest town or city street address of well if located within city? On 24 Hwy To BENTON RD. & Go South 1/4 mile From Manhattan Co North 4.5 miles

2 WATER WELL OWNER: MIKE HUENAGEL RR#, St. Address, Box #: 2515 BENTON City, State, ZIP Code: Manhattan, KS 66502 Application Number: Riley County Permit Board of Agriculture, Division of Water Resources

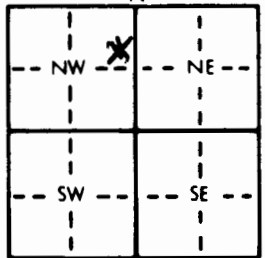3 LOCATE WELL'S LOCATION WITH AN "X" IN SECTION BOX:  4 DEPTH OF COMPLETED WELL: 40' ft. ELEVATION: 40' ft.

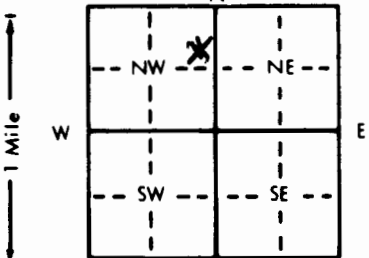

Depth(s) Groundwater Encountered: 1 25' ft. 2. .... ft. 3. .... ft.  
 WELL'S STATIC WATER LEVEL: 20' ft. below land surface measured on mo/day/yr  
 Pump test data: Well water was ..... ft. after ..... hours pumping ..... gpm  
 Est. Yield 50 gpm Well water was ..... ft. after ..... hours pumping ..... gpm  
 Bore Hole Diameter: 10" in. to 40' ft., and ..... in. to ..... ft.  
 WELL WATER TO BE USED AS: 5 Public water supply 8 Air conditioning 11 Injection well  
 1 Domestic 3 Feedlot 6 Oil field water supply 9 Dewatering 12 Other (Specify below)  
 2 Irrigation 4 Industrial 7 Lawn and garden only 10 Monitoring well  
 Was a chemical/bacteriological sample submitted to Department? Yes.....No.....; If yes, mo/day/yr sample was submitted  
 Water Well Disinfected? Yes  No

5 TYPE OF BLANK CASING USED: 1 Steel 3 RMP (SR) 5 Wrought iron 8 Concrete tile CASING JOINTS: Glued Clamped  
 2 PVC 4 ABS 7 Fiberglass 9 Other (specify below) Welded  
 Blank casing diameter: 5 in. to 20 ft. Dia. .... in. to ..... ft. Dia. .... in. to ..... ft.  
 Casing height above land surface: 11 in., weight 5.4 lbs./ft. Wall thickness or gauge No. ....

TYPE OF SCREEN OR PERFORATION MATERIAL: 1 Steel 3 Stainless steel 5 Fiberglass 8 RMP (SR) 10 Asbestos-cement  
 2 Brass 4 Galvanized steel 6 Concrete tile 9 ABS 11 Other (specify) .....  
 12 None used (open hole)  
 SCREEN OR PERFORATION OPENINGS ARE: 1 Continuous slot 3 Mill slot 10/1000's 5 Gauzed wrapped 8 Saw cut 11 None (open hole)  
 2 Louvered shutter 4 Key punched 6 Wire wrapped 9 Drilled holes  
 7 Torch cut 10 Other (specify) .....

SCREEN-PERFORATED INTERVALS: From 20 ft. to 40 ft., From ..... ft. to ..... ft.  
 From ..... ft. to ..... ft., From ..... ft. to ..... ft.  
 GRAVEL PACK INTERVALS: From 20 ft. to 40 ft., From ..... ft. to ..... ft.  
 From ..... ft. to ..... ft., From ..... ft. to ..... ft.

6 GROUT MATERIAL: 1 Neat cement 2 Cement grout 3 Bentonite 4 Other  
 Grout Intervals: From 0 ft. to 20 ft., From ..... ft. to ..... ft., From ..... ft. to ..... ft.

What is the nearest source of possible contamination: 1 Septic tank 4 Lateral lines 7 Pit privy 10 Livestock pens 14 Abandoned water well  
 2 Sewer lines 5 Cess pool 8 Sewage lagoon 11 Fuel storage 15 Oil well/Gas well  
 3 Watertight sewer lines 6 Seepage pit 9 Feedyard 12 Fertilizer storage 16 Other (specify below)  
 13 Insecticide storage  
 Direction from well? West How many feet? 120'

| FROM | TO | LITHOLOGIC LOG | FROM | TO | PLUGGING INTERVALS |
|------|----|----------------|------|----|--------------------|
| 0    | 1  | Top Soil       |      |    |                    |
| 1    | 25 | Brown Clay     |      |    |                    |
| 25   | 30 | Fine Gravel    |      |    |                    |
| 30   | 36 | Coarse Gravel  |      |    |                    |
| 36   | 40 | Grey Shale     |      |    |                    |

7 CONTRACTOR'S OR LANDOWNER'S CERTIFICATION: This water well was (1) constructed, (2) reconstructed, or (3) plugged under my jurisdiction and was completed on (mo/day/year) 12/9/99 and this record is true to the best of my knowledge and belief. Kansas Water Well Contractor's License No. 451 This Water Well Record was completed on (mo/day/yr) 01/14/00 under the business name of Holdeman Well Drilling by (signature) Cary A. Cup

OFFICE USE ONLY  
T  
R  
EW  
SEC.  
1/4  
1/4