


1 LOCATION OF WATER WELL: Fraction NE 1/4 SW 1/4 SW 1/4 Section Number 18 Township Number T 9 S Range Number R 8 E/W  
 County: Pott

Distance and direction from nearest town or city street address of well if located within city?  
on 24 + 1.5 miles East on 13 + 1/4 mile South From Manhattan 60 4 miles North

2 WATER WELL OWNER: Chuck Haulicik  
 RR#, St. Address, Box #: 1428 Erickson Board of Agriculture, Division of Water Resources  
 City, State, ZIP Code: Manhattan, KS 66503 Application Number:

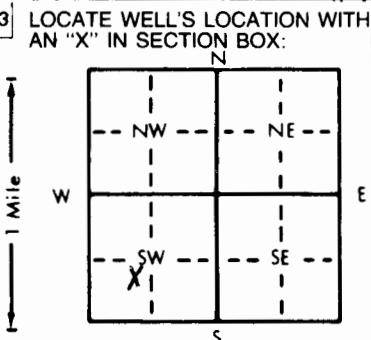

4 DEPTH OF COMPLETED WELL: 120 ft. ELEVATION:  
 Depth(s) Groundwater Encountered 1. 98 ft. 2. ft. 3. ft.  
 WELL'S STATIC WATER LEVEL: 95 ft. below land surface measured on mo/day/yr 4/20/98  
 Pump test data: Well water was ft. after hours pumping gpm  
 Est. Yield 30 gpm Well water was ft. after hours pumping gpm  
 Bore Hole Diameter: 9 in. to 120 ft. and in. to ft.  
 WELL WATER TO BE USED AS:  
 1 Domestic  3 Feedlot  6 Oil field water supply  9 Dewatering  12 Other (Specify below)  
 2 Irrigation  4 Industrial  7 Lawn and garden only  10 Monitoring well  
 Was a chemical/bacteriological sample submitted to Department? Yes  No  If yes, mo/day/yr sample was submitted  
 Water Well Disinfected?  Yes  No

5 TYPE OF BLANK CASING USED:  
 1 Steel  3 RMP (SR)  5 Wrought iron  8 Concrete tile CASING JOINTS:  Glued  Clamped  
 2 PVC  4 ABS  6 Asbestos-Cement  9 Other (specify below)  Welded  
 Blank casing diameter 5 in. to 100 ft. Dia. in. to ft. Dia. in. to ft. Dia. in. to ft.  
 Casing height above land surface: 24 in., weight 505 40 lbs./ft. Wall thickness or gauge No.  
 TYPE OF SCREEN OR PERFORATION MATERIAL:  
 1 Steel  3 Stainless steel  5 Fiberglass  8 RMP (SR)  10 Asbestos-cement  
 2 Brass  4 Galvanized steel  6 Concrete tile  9 ABS  11 Other (specify)  
 12 None used (open hole)  
 SCREEN OR PERFORATION OPENINGS ARE:  
 1 Continuous slot  2 Mill slot  5 Gauzed wrapped  8 Saw cut  11 None (open hole)  
 2 Louvered shutter  4 Key punched  6 Wire wrapped  9 Drilled holes  
 7 Torch cut  10 Other (specify)  
 SCREEN-PERFORATED INTERVALS: From 100 ft. to 120 ft., From ft. to ft., From ft. to ft.  
 GRAVEL PACK INTERVALS: From 20 ft. to 120 ft., From ft. to ft., From ft. to ft.

6 GROUT MATERIAL: 1 Neat cement 2 Cement grout  3 Bentonite 4 Other  
 Grout Intervals: From 0 ft. to 20 ft., From ft. to ft., From ft. to ft., From ft. to ft.  
 What is the nearest source of possible contamination:  
 1 Septic tank  4 Lateral lines  None Close  10 Livestock pens  14 Abandoned water well  
 2 Sewer lines  5 Cess pool  7 Pit privy  11 Fuel storage  15 Oil well/Gas well  
 3 Watertight sewer lines  6 Seepage pit  8 Sewage lagoon  12 Fertilizer storage  16 Other (specify below)  
 9 Feedyard  13 Insecticide storage  
 Direction from well? How many feet?

FROM	TO	LITHOLOGIC LOG	FROM	TO	PLUGGING INTERVALS
0	1	TOP Soil			
1	15	Brown clay			
15	22	lime stone			
22	31	Brown shale			
31	53	Greenish shale			
53	61	Brown shale			
61	72	lime stone			
72	96	Grey oily shale			
96	109	lime stone (washed)			
109	120	Grey shale			

7 CONTRACTOR'S OR LANDOWNER'S CERTIFICATION: This water well was  (1) constructed,  (2) reconstructed, or  (3) plugged under my jurisdiction and was completed on (mo/day/year) 4/20/98 and this record is true to the best of my knowledge and belief. Kansas Water Well Contractor's License No. 451 This Water Well Record was completed on (mo/day/yr) 5/18/98 under the business name of Haldeman by (signature) Wayne Haldeman CWD/PO

OFFICE USE ONLY T R EW SEC.