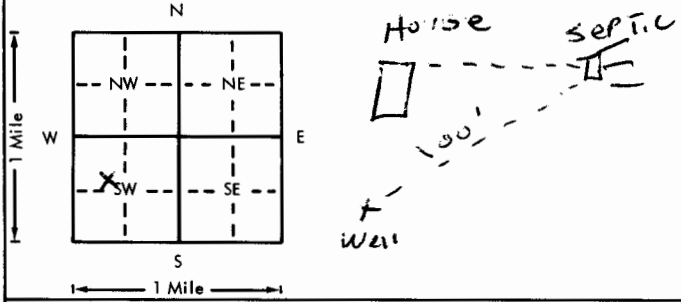


USE TYPEWRITER OR BALL  
POINT PEN-PRESS FIRMLY,  
PRINT CLEARLY.

WATER WELL RECORD  
KSA 82a-1201-1215

Kansas Department of Health and  
Environment-Division of Environment  
(Water well Contractors)  
Topeka, Kansas 66620

1. Location of well: County <u>Pottawatomie</u> Fraction <u>SE 1/4 NW 1/4 SW 1/4</u> Section number <u>7</u> Township number <u>T 9 S 8 E</u> Range number <u>8</u>	
2. Distance and direction from nearest town or city: <u>6 N</u> 3. Owner of well: <u>Don KUMIGER</u> Street address of well location if in city: <u>MANHATTAN, KS.</u> R.R. or street: <u>RT 5 BOX 845</u> City, state, zip code: <u>MANHATTAN, KS.</u>	
4. Locate with "X" in section below: Sketch map: 	
5. Type and color of material	
6. Bore hole dia. <u>5</u> in. Completion date <u>10-9-76</u> Well depth <u>250</u> ft.	
7. <input checked="" type="checkbox"/> Cable tool <input checked="" type="checkbox"/> Rotary <input type="checkbox"/> Driven <input type="checkbox"/> Dug <input type="checkbox"/> Hollow rod <input type="checkbox"/> Jetted <input type="checkbox"/> Bored <input type="checkbox"/> Reverse rotary	
8. Use: <input checked="" type="checkbox"/> Domestic <input type="checkbox"/> Public supply <input type="checkbox"/> Industry <input type="checkbox"/> Irrigation <input type="checkbox"/> Air conditioning <input type="checkbox"/> Stock <input type="checkbox"/> Lawn <input type="checkbox"/> Oil field water <input type="checkbox"/> Other	
9. Casing: Material <u>PVC</u> Height: <u>Above</u> or below Threaded <input type="checkbox"/> Welded <input type="checkbox"/> Surface <u>24</u> in. RMP <input type="checkbox"/> PVC <input checked="" type="checkbox"/> Weight <u>2.55</u> lbs./ft. Dia. <u>5</u> in. to <u>25</u> ft. depth Wall Thickness: inches or Dia. <u>5</u> in. to <u>25</u> ft. depth gage No. <u>2.74</u>	
10. Screen: Manufacturer's name <u>Pumpco</u> Type <u>PVC</u> Dia. <u>5</u> Slot/gauze <u>200</u> Length <u>40</u> Set between <u>180</u> ft. and <u>120</u> ft. <u>180</u> ft. and <u>200</u> ft. Gravel pack? <input checked="" type="checkbox"/> Size range of material <u>1/4 x 1/8</u>	
11. Static water level: <u>120</u> ft. below land surface Date <u>10-9-76</u>	
12. Pumping level below land surfaces: <u>Air Test</u> ____ ft. after ____ hrs. pumping ____ g.p.m. ____ ft. after ____ hrs. pumping ____ g.p.m. Estimated maximum yield <u>145-150</u> g.p.m.	
13. Water sample submitted: <u>Yes</u> <input checked="" type="checkbox"/> No <input type="checkbox"/> Date ____	
14. Well head completion: <u>CAP</u> ____ Pitless adapter <u>29</u> inches above grade	
15. Well grouted? <input checked="" type="checkbox"/> With: <input type="checkbox"/> Neat cement <input type="checkbox"/> Bentonite <input type="checkbox"/> Concrete Depth: From <u>5</u> ft. to <u>15</u> ft.	
16. Nearest source of possible contamination: <u>SEMANA</u> ft. <u>500</u> Direction <u>E</u> Type <u>SEMANA</u> Well disinfected upon completion? <input checked="" type="checkbox"/> Yes <input type="checkbox"/> No	
17. Pump: <input checked="" type="checkbox"/> Not installed Manufacturer's name ____ Model number ____ HP ____ Volts ____ Length of drop pipe ____ ft. capacity ____ g.p.m. Type: <input type="checkbox"/> Submersible <input type="checkbox"/> Turbine <input type="checkbox"/> Jet <input type="checkbox"/> Reciprocating <input type="checkbox"/> Centrifugal <input type="checkbox"/> Other	
18. Elevation: Topography: <input checked="" type="checkbox"/> Hill <input type="checkbox"/> Slope <input type="checkbox"/> Upland <input type="checkbox"/> Valley	
19. Remarks: <u>OWNER WILL INSTALL SLAB</u>	
20. Water well contractor's certification: This well was drilled under my jurisdiction and this report is true to the best of my knowledge and belief. <u>STRODER DRY CO INC 182</u> Business name License No. <u>RT 1 HOLTON KS.</u> Address <u>Dale Padron</u> Date <u>10-11-76</u> Signed <u>Dale Padron</u> Authorized representative	

Forward the white, blue and pink copies to the Department of Health and Environment

Form WWC-5