


1 LOCATION OF WATER WELL: Fraction NE 1/4 NE 1/4 SW 1/4 Section Number 18 Township Number T 9 S Range Number R 8 E
 County: Pottawatomie

Distance and direction from nearest town or city street address of well if located within city? From Manhattan Mo 4 miles north to Highway 13 + Go 1.75 miles east to Spillway Marina Rd + Go 1/2 mile north

2 WATER WELL OWNER: Al Wood
 RR#, St. Address, Box #: 6733 Deer Trail + Spillway Marina Rd. Board of Agriculture, Division of Water Resources
 City, State, ZIP Code: Manhattan, Kansas 66502 Application Number:

3 LOCATE WELL'S LOCATION WITH AN "X" IN SECTION BOX:

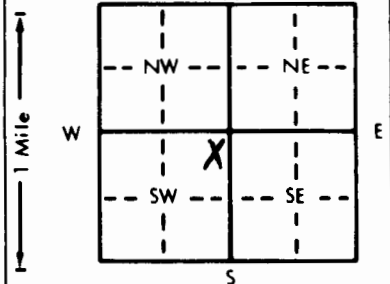

4 DEPTH OF COMPLETED WELL: 200' ft. ELEVATION:

Depth(s) Groundwater Encountered 1. 158 ft. 2. ft. 3. ft.
 WELL'S STATIC WATER LEVEL: 63' ft. below land surface measured on mo/day/yr
 Pump test data: Well water was ft. after hours pumping gpm
 Est. Yield 30* gpm: Well water was ft. after hours pumping gpm
 Bore Hole Diameter: 9 in. to 200 ft., and in. to ft.
 WELL WATER TO BE USED AS:
 1 Domestic 3 Feedlot 6 Oil field water supply 9 Dewatering 12 Other (Specify below)
 2 Irrigation 4 Industrial 7 Lawn and garden only 10 Monitoring well
 Was a chemical/bacteriological sample submitted to Department? Yes No; If yes, mo/day/yr sample was submitted Water Well Disinfected? Yes No

5 TYPE OF BLANK CASING USED:
 1 Steel 3 RMP (SR) 6 Asbestos-Cement 9 Other (specify below) CASING JOINTS: Glued Clamped
 2 PVC 4 ABS 7 Fiberglass Threaded

Blank casing diameter: 5 in. to 180 ft., Dia. in. to ft., Dia. in. to ft.
 Casing height above land surface: 3 in., weight Sch 40 lbs./ft. Wall thickness or gauge No.

TYPE OF SCREEN OR PERFORATION MATERIAL:
 1 Steel 3 Stainless steel 5 Fiberglass 7 PVC 10 Asbestos-cement
 2 Brass 4 Galvanized steel 6 Concrete tile 9 ABS 11 Other (specify)
 12 None used (open hole)

SCREEN OR PERFORATION OPENINGS ARE:
 1 Continuous slot 6 Mill slot 25/1000^s 5 Gauzed wrapped 8 Saw cut 11 None (open hole)
 2 Louvered shutter 4 Key punched 7 Torch cut 9 Drilled holes 10 Other (specify)

SCREEN-PERFORATED INTERVALS: From 180 ft. to 200 ft., From ft. to ft.
 GRAVEL PACK INTERVALS: From 25 ft. to 200 ft., From ft. to ft.

6 GROUT MATERIAL: 1 Neat cement 2 Cement grout 3 Bentonite 4 Other
 Grout Intervals: From 0 ft. to 25 ft., From ft. to ft., From ft. to ft.

What is the nearest source of possible contamination: None, Close Pit privy
 1 Septic tank 4 Lateral lines 7 Pit privy 10 Livestock pens 14 Abandoned water well
 2 Sewer lines 5 Cess pool 8 Sewage lagoon 11 Fuel storage 15 Oil well/Gas well
 3 Watertight sewer lines 6 Seepage pit 9 Feedyard 12 Fertilizer storage 16 Other (specify below)
 13 Insecticide storage

Direction from well? How many feet?

FROM	TO	LITHOLOGIC LOG	FROM	TO	PLUGGING INTERVALS
0	1	Top Soil	134	136	Limestone
1	4	Limestone	136	158	Brown shale
4	12	Brown shale	158	167	Limestone (Water)
12	18	Grey shale	167	174	Brown shale
18	33	Brown shale	174	177	Limestone
33	41	Greenish shale	177	186	Greenish shale
41	47	Brown shale	186	190	Limestone
47	53	Limestone	190	200	Grey shale
53	67	Brown shale			
67	70	Limestone			
70	82	Brown shale			
82	90	Limestone			
90	105	Greenish shale			
105	115	Limestone			
115	134	Brown shale			

7 CONTRACTOR'S OR LANDOWNER'S CERTIFICATION: This water well was (1) constructed, (2) reconstructed, or (3) plugged under my jurisdiction and was completed on (mo/day/year) 6/8/94 and this record is true to the best of my knowledge and belief. Kansas Water Well Contractor's License No. 451 This Water Well Record was completed on (mo/day/yr) 6/23/94 under the business name of Holdeman W & Drilling by (signature) Craig