USE TYPEWRITER OR BALL POINT PEN-PRESS FIRMLY, PRINT CLEARLY.

WATER WELL RECORD
KSA 82a-1201-1215

Kansas Department of Health and Environment-Division of Environment
(Water well Contractors)
Topeka, Kansas 66620

1. Location of well:	County	Fraction	Section number	Township number	Range number
	Pottawatomie	SE 1/4 NE 1/4 SE 1/4	24	T 9 S	R 8 E/W

2. Distance and direction from nearest town or city: 4 N 2 W
Street address of well location if in city: St. George

3. Owner of well: Gary Honeycutt
R.R. or street: RR.
City, state, zip code: St. George, Ks

4. Locate with "X" in section below:

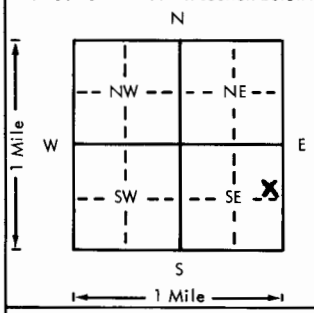

Sketch map:

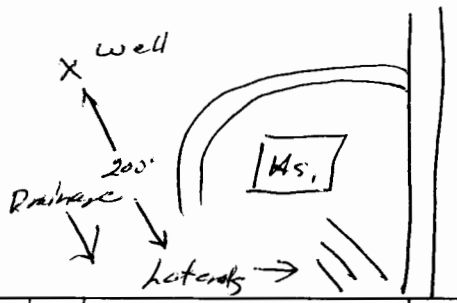

6. Bore hole dia. 8 in. Completion date
Well depth 120 ft. 10-5-77

7. ___ Cable tool X Rotary ___ Driven ___ Dug
___ Hollow rod ___ Jetted ___ Bored ___ Reverse rotary

8. Use: X Domestic ___ Public supply ___ Industry
___ Irrigation ___ Air conditioning ___ Stock
___ Lawn ___ Oil field water ___ Other

9. Casing: Material PVC Height (Above) or below
Threaded ___ Welded ___ Surface 24 in.
RMP ___ PVC Glue Weight 2.74 lbs./ft.
Dia. 5 in. to 120 ft. depth Wall Thickness: inches or
Dia. ___ in. to ___ ft. depth gage No. 1258

5. Type and color of material				From	To
Fill	0	1	Yellow limestone	57	62
Tan Shaley L.S.	1	3	Gray Shale	62	71
Tan Limestone	3	15	Tan Shale	71	80
Tan Shale	15	18	Tan Limestone	80	85
Lt Gray Shaley L.S.	18	21	Yellow Gray L.S.	85	92
Tan-Gray Shale	21	23	Tan Limestone	92	93
Tan L.S. Shaley	23	26	Lt. Gray Limestone	93	101
Gray Shale	26	27	Gray Shale	101	103
Tan Limestone	27	32	Black Shale	103	104
Gray Shale	32	37	Gray Limestone	104	120
Tan limestone	37	41			
Tan Shale	41	47			
Tan limestone	47	49			
Brown Shale	49	52			
Tan Shale	52	57			

(Use a second sheet if needed)

10. Screen: Manufacturer's name Pumpco
Type PVC Dia. 5"
Slot/gauze .080 Length 25
Set between 75 ft. and 100 ft.
___ ft. and ___ ft.
Gravel pack? Yes Size range of material 1/4 x 1/8

11. Static water level: mo./day/yr.
70 ft. below land surface Date 10-5-77

12. Pumping level below land surfaces: Air Test
___ ft. after ___ hrs. pumping ___ g.p.m.
___ ft. after ___ hrs. pumping ___ g.p.m.
Estimated maximum yield 6 g.p.m.

13. Water sample submitted: mo./day/yr.
___ Yes X No Date

14. Well head completion: Top Cap
___ Pitless adapter 24 Inches above grade

15. Well grouted? Yes
With: X Neat cement ___ Bentonite ___ Concrete
Depth: From 0' ft. to 10 ft.

16. Nearest source of possible contamination:
ft. 200 Direction SE Type Laterals
Well disinfected upon completion? Yes Yes ___ No

17. Pump: X Not installed
Manufacturer's name
Model number HP Volts
Length of drop pipe ft. capacity g.p.m.
Type:
___ Submersible ___ Turbine
___ Jet ___ Reciprocating
___ Centrifugal ___ Other

18. Elevation:

Topography:
X Hill
___ Slope
___ Upland
___ Valley

19. Remarks: Owner to pour cement Slab.

20. Water well contractor's certification:
This well was drilled under my jurisdiction and this report is true to the best of my knowledge and belief.
Strader Drlg Co 182
Business name License No.
Address Hoiton, Ks
Signed Dale Askeran Date 10-10-77
Authorized representative

T 9 R 8 (E) W Sec 24 SE NESE 1/4 1/4 1/4

Forward the white, blue and pink copies to the Department of Health and Environment

Form WWC-5