


USE TYPEWRITER OR BALL POINT PEN-PRESS FIRMLY, PRINT CLEARLY.

WATER WELL RECORD  
KSA 82a-1201-1215

Kansas Department of Health and Environment-Division of Environment (Water well Contractors) Topeka, Kansas 66620

1. Location of well: County POTAWATOMIE Fraction NW 1/4 NW 1/4 NW 1/4 Section number 27 Township number T 9 S Range number R 8 E

2. Distance and direction from nearest town or city: 4.5 SW of 3. Owner of well: COFFMAN plumbing  
Street address of well location if in city: Flush R.R. or street: R.T. 5  
City, state, zip code: MANHATTAN, KANSAS

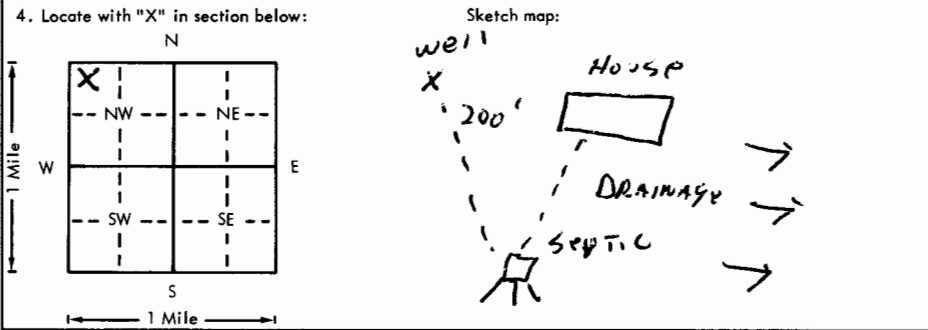

6. Bore hole dia. 10 in. Completion date 10-27-77  
Well depth 80 ft.

7. Cable tool  Rotary  Driven  Dug  
 Hollow rod  Jetted  Bored  Reverse rotary

8. Use:  Domestic  Public supply  Industry  
 Irrigation  Air conditioning  Stock  
 Lawn  Oil field water  Other

9. Casing: Material PVC Height: Above or below  
Threaded  Welded  Surface 29 in.  
RMP  PVC 94 Weight 2.50 lbs./ft.  
Dia. 5 in. to 80 ft. depth Wall Thickness: inches or  
Dia.     in. to     ft. depth gage No.    

5. Type and color of material	From	To
<u>TOP SOIL</u>	<u>0</u>	<u>3</u>
<u>CLAY, BR</u>	<u>3</u>	<u>18</u>
<u>Limestone, grey</u>	<u>18</u>	<u>35</u>
<u>shale, grey</u>	<u>35</u>	<u>47</u>
<u>Limestone, yellow</u>	<u>47</u>	<u>50</u>
<u>shale, grey</u>	<u>50</u>	<u>65</u>
<u>Limestone, loose, grey</u>	<u>65</u>	<u>66</u>
<u>shale, grey</u>	<u>66</u>	<u>80</u>
(Use a second sheet if needed)		

10. Screen: Manufacturer's name Pumpco MPI  
Type PVC Dia. 5  
log gauze .020 Length 40  
Set between 90 ft. and 80 ft.  
ft. and     ft.  
Gravel pack?  Size range of material 10/30 x .060

11. Static water level: 50 ft. below land surface Date 10-27-77 mo./day/yr.

12. Pumping level below land surfaces:  
    ft. after     hrs. pumping     g.p.m.  
    ft. after     hrs. pumping     g.p.m.  
Estimated maximum yield 30 g.p.m.

13. Water sample submitted:     mo./day/yr.  
 Yes  No Date    

14. Well head completion: CAP  
    Pitless adapter 29 Inches above grade

15. Well grouted?   
With:  Neat cement  Bentonite  Concrete  
Depth: From 0 ft. to 10 ft.

16. Nearest source of possible contamination:  
ft. 200 Direction S Type SEPTIC  
Well disinfected upon completion?  Yes  No

17. Pump:  Not installed  
Manufacturer's name      
Model number     HP     Volts      
Length of drop pipe     ft. capacity     g.p.m.  
Type:  
 Submersible  Turbine  
 Jet  Reciprocating  
 Centrifugal  Other

18. Elevation:  
Topography:  
 Hill  
 Slope  
 Upland  
 Valley

19. Remarks:  
OWNER TO INSTAL SLAB

20. Water well contractor's certification:  
This well was drilled under my jurisdiction and this report is true to the best of my knowledge and belief.  
Strader Dalg Co Inc 182  
Business name License No.      
Address Halton, KS  
Signed Don Ashm Date 10-27-77  
Authorized representative

T-9 R-8 S-27 Sec 27 NW 1/4 NE 1/4