


1 LOCATION OF WATER WELL: Fraction $\frac{1}{4}$ NW $\frac{1}{4}$ SE $\frac{1}{4}$ Section Number 28 Township Number T 9 S Range Number R 8 E/W
 County: Pottawatomie

Distance and direction from nearest town or city street address of well if located within city? Go 2 miles EAST FROM MANHATTAN ON 24 Highway To Green Valley Rd. Then Go 1 mile North Then Go 1 mile WEST Then 2 miles North East on STATE LAKE ROAD

2 WATER WELL OWNER: SHORTY COFFMAN
 RR#, St. Address, Box #: RR# 5
 City, State, ZIP Code: Manhattan, Kansas 66502
 Board of Agriculture, Division of Water Resources
 Application Number:

3 LOCATE WELL'S LOCATION WITH AN "X" IN SECTION BOX:

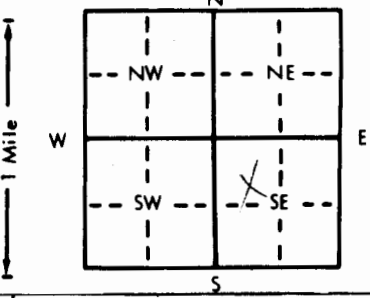

4 DEPTH OF COMPLETED WELL: 80' ft. ELEVATION:

Depth(s) Groundwater Encountered 1. 5.8 ft. 2. ft. 3. ft.

WELL'S STATIC WATER LEVEL: 50 ft. below land surface measured on mo/day/yr

Pump test data: Well water was ft. after hours pumping gpm

Est. Yield 40 gpm: Well water was ft. after hours pumping gpm

Bore Hole Diameter: 8 in. to 80' ft., and in. to ft.

WELL WATER TO BE USED AS: 5 Public water supply 8 Air conditioning 11 Injection well

1 Domestic 3 Feedlot 6 Oil field water supply 9 Dewatering 12 Other (Specify below)

2 Irrigation 4 Industrial 7 Lawn and garden only 10 Monitoring well

Was a chemical/bacteriological sample submitted to Department? Yes No; If yes, mo/day/yr sample was submitted

Water Well Disinfected? Yes No

5 TYPE OF BLANK CASING USED: 5 Wrought iron 8 Concrete tile CASING JOINTS: Glued Clamped

1 Steel 3 RMP (SR) 6 Asbestos-Cement 9 Other (specify below) Welded Seamed

2 PVC 4 ABS 7 Fiberglass Threaded

Blank casing diameter: 5 in. to 70 ft., Dia. in. to ft., Dia. in. to ft.

Casing height above land surface: 2' in., weight Sch 40 lbs./ft. Wall thickness or gauge No.

TYPE OF SCREEN OR PERFORATION MATERIAL: 7 PVC 10 Asbestos-cement

1 Steel 3 Stainless steel 5 Fiberglass 8 RMP (SR) 11 Other (specify)

2 Brass 4 Galvanized steel 6 Concrete tile 9 ABS 12 None used (open hole)

SCREEN OR PERFORATION OPENINGS ARE: 3 Mill slot 5 Gauzed wrapped 8 Saw cut 11 None (open hole)

1 Continuous slot 2 Louvered shutter 4 Key punched 6 Wire wrapped 9 Drilled holes

7 Torch cut 10 Other (specify)

SCREEN-PERFORATED INTERVALS: From 70 ft. to 80 ft., From ft. to ft.

GRAVEL PACK INTERVALS: From 20 ft. to 80 ft., From ft. to ft.

6 GROUT MATERIAL: 1 Neat cement 2 Cement grout 3 Bentonite 4 Other

Grout Intervals: From 0 ft. to 20 ft., From ft. to Emerging ft., From ft. to ft.

What is the nearest source of possible contamination: None Close

1 Septic tank 4 Lateral lines 7 Pit privy 10 Livestock pens 14 Abandoned water well

2 Sewer lines 5 Cess pool 8 Sewage lagoon 11 Fuel storage 15 Oil well/Gas well

3 Watertight sewer lines 6 Seepage pit 9 Feedyard 12 Fertilizer storage 16 Other (specify below)

13 Insecticide storage

Direction from well? How many feet?

FROM	TO	LITHOLOGIC LOG	FROM	TO	PLUGGING INTERVALS
0	6	Grey Shale			
6	8	Limestone			
8	15	Grey Shale			
15	26	Rock			
26	31	Brown shale			
31	34	Grey Shale			
34	37	Limestone			
37	51	Grey Shale			
52	53	Limestone			
53	58	Grey Shale			
58	67	Rock (Water)			
67	69	Grey Shale			
69	71	Rock			
71	80	Grey Shale			

7 CONTRACTOR'S OR LANDOWNER'S CERTIFICATION: This water well was (1) constructed, (3) reconstructed, or (3) plugged under my jurisdiction and was completed on (mo/day/year) 2/14/88 and this record is true to the best of my knowledge and belief. Kansas

Water Well Contractor's License No. 451 This Water Well Record was completed on (mo/day/yr) 2/6/89

Under the business name of Holdeman Well Drilling by (signature) Gregory