


1 LOCATION OF WATER WELL: Fraction $\frac{1}{4}$ C. West $\frac{1}{4}$ SE $\frac{1}{4}$ Section Number 32 Township Number T 9 S Range Number R 8 EW
 County: Pott. Distance and direction from nearest town or city street address of well if located within city? From Int. Of U.S. Hiway 24 and Green Valley Rd. east of Manhattan, north to Junietta Rd. west 2 mi. and 1300' north

2 WATER WELL OWNER: Harry Wickstrum Board of Agriculture, Division of Water Resources
 RR#, St. Address, Box #: Route 1 Application Number: 39,899
 City, State, ZIP Code: Weastmoreland Ks.

3 LOCATE WELL'S LOCATION WITH AN "X" IN SECTION BOX:

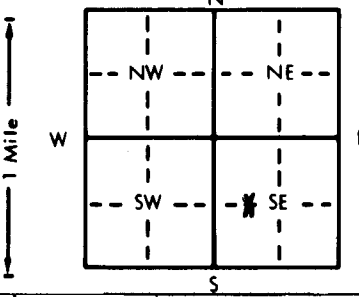

4 DEPTH OF COMPLETED WELL: 47 ft. ELEVATION:
 Depth(s) Groundwater Encountered 1. 26 ft. 2. ft. 3. X ft.
 WELL'S STATIC WATER LEVEL 26 ft. below land surface measured on mo/day/yr ~~2-25-91~~
 Pump test data: Well water was 44 ft. after 1 hours pumping 500 gpm
 Est. Yield 600 gpm: Well water was 45 ft. after 2 hours pumping 500 gpm
 Bore Hole Diameter: 32 in. to 47 ft., and in. to ft.
 WELL WATER TO BE USED AS: 5 Public water supply 8 Air conditioning 11 Injection well
 1 Domestic 3 Feedlot 6 Oil field water supply 9 Dewatering 12 Other (Specify below)
 2 Irrigation 4 Industrial 7 Lawn and garden only 10 Monitoring well
 Was a chemical/bacteriological sample submitted to Department? Yes.....No. X.....; If yes, mo/day/yr sample was submitted
 Water Well Disinfected? Yes No X

5 TYPE OF CASING USED: 5 Wrought iron 8 Concrete tile CASING JOINTS: Glued X Clamped
 1 Steel 3 RMP (SR) Welded
 2 PVC 4 ABS 7 Fiberglass Threaded
 Blank casing diameter 16 in. to 27 ft., Dia in. to ft., Dia in. to ft.
 Casing height above land surface in., weight lbs./ft. Wall thickness or gauge No. 65

TYPE OF SCREEN OR PERFORATION MATERIAL: 7 PVC 10 Asbestos-cement
 1 Steel 3 Stainless steel 5 Fiberglass 8 RMP (SR) 11 Other (specify)
 2 Brass 4 Galvanized steel 6 Concrete tile 9 ABS 12 None used (open hole)

SCREEN OR PERFORATION OPENINGS ARE: 5 Gauzed wrapped 8 Saw cut 11 None (open hole)
 1 Continuous slot 3 Mill slot 6 Wire wrapped 9 Drilled holes
 2 Louvered shutter 4 Key punched 7 Torch cut 10 Other (specify)

SCREEN-PERFORATED INTERVALS: From 27 ft. to 47 ft., From ft. to ft.
 From ft. to ft., From ft. to ft.
 GRAVEL PACK INTERVALS: From 20 ft. to 47 ft., From ft. to ft.
 From ft. to ft., From ft. to ft.

6 GROUT MATERIAL: 1 Neat cement 2 Cement grout 3 Bentonite 4 Other
 Grout Intervals: From 0 ft. to 20 ft., From ft. to ft., From ft. to ft.

What is the nearest source of possible contamination:
 1 Septic tank 4 Lateral lines 7 Pit privy 10 Livestock pens 14 Abandoned water well
 2 Sewer lines 5 Cess pool 8 Sewage lagoon 11 Fuel storage 15 Oil well/Gas well
 3 Watertight sewer lines 6 Seepage pit 9 Feedyard 12 Fertilizer storage 16 Other (specify below)
 13 Insecticide storage None
 Direction from well? How many feet?

FROM	TO	LITHOLOGIC LOG	FROM	TO	PLUGGING INTERVALS
0	4	Sandy silt			
4	11	Black silt			
11	22	fine brown sand			
22	26	medium-large brown gravel			
26	28	medium gray gravel			
28	34	medium-large gray gravel and gray clay			
34	36	small-medium gray gravel			
36	38	medium green gravel			
38	41	small-medium green gravel			
41	47	medium-large green gravel			
	47	yellow until stopped			

7 CONTRACTOR'S OR LANDOWNER'S CERTIFICATION: This water well was (1) constructed, (2) reconstructed, or (3) plugged under my jurisdiction and was completed on (mo/day/year) 2-28-91 and this record is true to the best of my knowledge and belief. Kansas Water Well Contractor's License No. 323 This Water Well Record was completed on (mo/day/yr) 3-13-91 under the business name of Hoobler Drilling Co. by (signature)

OFFICE USE ONLY T R EW SEC 1/4 1/4 1/4