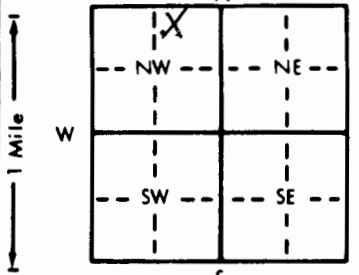


1 LOCATION OF WATER WELL: County: Pottawatomie Fraction: NW 1/4 NE 1/4 NW 1/4 Section Number: 31 Township Number: T 9 S Range Number: R 9 E

Distance and direction from nearest town or city street address of well if located within city? From Manhattan KS 5 miles west on 24th then go 2 miles north on gravel & 1/4 mile west

2 WATER WELL OWNER: Nelson Poultry  
 RR#, St. Address, Box #: East Hwy 24  
 City, State, ZIP Code: Manhattan, KS 66502  
 Board of Agriculture, Division of Water Resources  
 Application Number:

3 LOCATE WELL'S LOCATION WITH AN "X" IN SECTION BOX:  
  
 4 DEPTH OF COMPLETED WELL: 5.6 ft. ELEVATION:  
 Depth(s) Groundwater Encountered 1. 3.5 ft. 2. ft. 3. ft.  
 WELL'S STATIC WATER LEVEL: 3.5 ft. below land surface measured on mo/day/yr  
 Pump test data: Well water was ... ft. after ... hours pumping ... gpm  
 Est. Yield: 15 gpm: Well water was ... ft. after ... hours pumping ... gpm  
 Bore Hole Diameter: 10 in. to 5.6 ft., and ... in. to ... ft.  
 WELL WATER TO BE USED AS:  
 1 Domestic 3 Feedlot 5 Public water supply 8 Air conditioning 11 Injection well  
 2 Irrigation 4 Industrial 6 Oil field water supply 9 Dewatering 12 Other (Specify below)  
7 Livestock Chickens  
 Was a chemical/bacteriological sample submitted to Department? Yes ... No ... If yes, mo/day/yr sample was submitted  
 Water Well Disinfected? Yes  No

5 TYPE OF BLANK CASING USED:  
 1 Steel  3 RMP (SR)  
 2 PVC  4 ABS  
 5 Wrought iron 8 Concrete tile CASING JOINTS: Glued Clamped  
 6 Asbestos-Cement 9 Other (specify below) Welded  
 7 Fiberglass Threaded  
 Blank casing diameter: 5 in. to 3.6 ft., Dia. ... in. to ... ft., Dia. ... in. to ... ft.  
 Casing height above land surface: 2 in., weight Sch 40 lbs./ft. Wall thickness or gauge No.  
 TYPE OF SCREEN OR PERFORATION MATERIAL:  
 1 Steel 3 Stainless steel 5 Fiberglass 7 PVC  10 Asbestos-cement  
 2 Brass 4 Galvanized steel 6 Concrete tile 8 RMP (SR) 11 Other (specify)  
 9 ABS 12 None used (open hole)  
 SCREEN OR PERFORATION OPENINGS ARE:  
 1 Continuous slot 3 Mill slot 10/1000 5 Gauzed wrapped 8 Saw cut 11 None (open hole)  
 2 Louvered shutter 4 Key punched 6 Wire wrapped 9 Drilled holes  
 7 Torch cut 10 Other (specify)  
 SCREEN-PERFORATED INTERVALS: From 3.6 ft. to 5.6 ft., From ... ft. to ... ft.  
 GRAVEL PACK INTERVALS: From 2.5 ft. to 5.6 ft., From ... ft. to ... ft.

6 GROUT MATERIAL: 1 Neat cement 2 Cement grout 3 Bentonite  4 Other  
 Grout Intervals: From 0 ft. to 2.5 ft., From ... ft. to ... ft., From ... ft. to ... ft.  
 What is the nearest source of possible contamination: None Close  
 1 Septic tank 4 Lateral lines Pit privy 10 Livestock pens 14 Abandoned water well  
 2 Sewer lines 5 Cess pool 8 Sewage lagoon 11 Fuel storage 15 Oil well/Gas well  
 3 Watertight sewer lines 6 Seepage pit 9 Feedyard 12 Fertilizer storage 16 Other (specify below)  
 13 Insecticide storage  
 Direction from well? How many feet?

FROM	TO	LITHOLOGIC LOG	FROM	TO	PLUGGING INTERVALS
0	1	Top Soil			
1	30	Brown Clay			
30	48	Sandy Brown Clay (WATH)			
48	52	Fine Sand			
52	56	Grey Shale			
56	57	Limestone			

7 CONTRACTOR'S OR LANDOWNER'S CERTIFICATION: This water well was (1) constructed, (2) reconstructed, or (3) plugged under my jurisdiction and was completed on (mo/day/year) 12/5/95 and this record is true to the best of my knowledge and belief. Kansas Water Well Contractor's License No. 451 This Water Well Record was completed on (mo/day/yr) 12/10/95 under the business name of Halderson Well Drilling by (signature) Craig H. Halderson (MWD/PE)