


1 LOCATION OF WATER WELL: Fraction _____ Section Number 33 Township Number 9 Range Number 9 (E)N
 County: POTTAWATOMIE NW 1/4 SE 1/4 SW 1/4

Distance and direction from nearest town or city street address of well if located within city?
FROM WAMEGO: 6 MILES WEST ON HWY 24, 1 MILE NORTH ON BLACK JACK RD, 1/4 MILE EAST.

2 WATER WELL OWNER: JOBY HARRISON
 RR #, St. Address, Box #: 3000 CHESTNUT
 City, State, ZIP Code: ST. GEORGE, KS 66535
 Board of Agriculture, Division of Water Resources
 Application Number: _____

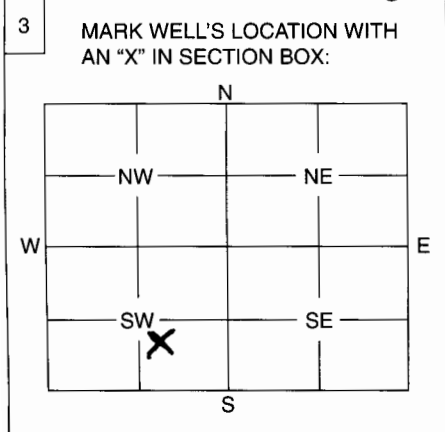

4 DEPTH OF WELL 85 ft.
 WELL'S STATIC WATER LEVEL 69 ft.
 WELL WAS USED AS:
 Domestic 5 Public Water Supply 9 Dewatering
 2 Irrigation 6 Oil Field Water Supply 10 Monitoring Well
 3 Feedlot 7 Domestic (Lawn & Garden) 11 Injection Well
 4 Industrial 8 Air Conditioning 12 Other

Was a chemical / bacteriological sample submitted to Department? Yes No X
 If yes, mo/day/yr sample was submitted

Water Well Disinfected: Yes X No

5 TYPE OF BLANK CASING USED:
 1 Steel 3 RMP (SR) 5 Wrought 7 Fiberglass 9 Other (Specify below)
 2 PVC 4 ABS 6 Asbestos-Cement 8 Concrete Tile

Blank casing diameter 6 in. Was casing pulled? Yes X No If yes, how much 36 INCHES

Casing height above or below land surface 36 in.

6 GROUT PLUG MATERIAL: 1 Neat cement 2 Cement grout 3 Bentonite 4 Other

Grout Plug Intervals: From 3 ft. to 85 ft., From ft. to ft., From to ft.

What is the nearest source of possible contamination:
 1 Septic tank 6 Seepage pit 11 Fuel storage 16 Other (specify below)
 2 Sewer lines 7 Pit privy 12 Fertilizer storage WAS IN AN OPEN LOT. BUT HAS HAD A HOUSE MOVED IN ON THE WEST SIDE OF THE ABANDON WELL
 3 Watertight sewer lines 8 Sewage lagoon 13 Insecticide storage
 4 Lateral lines 9 Feedyard 14 Abandoned water well
 5 Cess pool 10 Livestock pens 15 Oil well/Gas well

Direction from well? How many feet?

FROM	TO	PLUGGING MATERIALS
<u>3</u>	<u>85</u>	<u>BENTONITE (24 BAGS)</u>

7 CONTRACTOR'S OF LANDOWNER'S CERTIFICATION: This water well was plugged under my jurisdiction and was completed on (mo/day/year) 1/10/06 and this record is true to the best of my knowledge and belief. Kansas Water Well Contractor's License No. 760 This Water Well Record was completed on (mo/day/year) 2/6/06 under the business name of ASSOCIATED DRELLING, INC. by (signature) [Signature]

INSTRUCTIONS: Use typewriter or ball point pen. Please press firmly and print clearly. Please fill in blanks, underline or circle the correct answers. Send top three copies to Kansas Department of Health and Environment, Bureau of Water, Geology Section, 1000 SW Jackson St., Ste. 420, Topeka, Kansas 66612-1367. Telephone: 785/296-5522. Send one to Water Well Owner and retain one for your records.