


1 LOCATION OF WATER WELL: County: Pottawatomie	Fraction SW 1/4 SW 1/4 NE 1/4	Section Number 27	Township Number T 9 S	Range Number R 9 (E) W
Distance and direction from nearest town or city street address of well if located within city? Approximately 3/4 mile south and 4 1/4 miles west of Louisville		Global Positioning Systems (decimal degrees, min. of 4 digits) Latitude: 39.240588 Longitude: -96.398394 Elevation: Unknown Datum: NAD83 Data Collection Method: WAAS GPS Unit		

2 WATER WELL OWNER: Pottawatomie County RWD #1
 RR#, St. Address, Box # : P.O. Box 233
 City, State, ZIP Code : Wamego, KS 66547

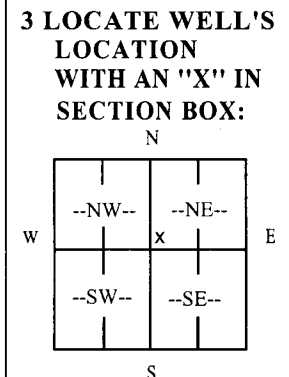

4 DEPTH OF COMPLETED WELL 160.21 ft.
 Depth(s) Groundwater Encountered (1) _____ ft. (2) _____ ft. (3) _____ ft.
WELL'S STATIC WATER LEVEL 88 ft. below land surface measured on mo/day/yr. 04-24-07
 Pump test data: Well water was Not checked ft. after _____ hours pumping _____ gpm
 Est. Yield Unknown gpm: Well water was _____ ft. after _____ hours pumping _____ gpm
WELL WATER TO BE USED AS: **(5)** Public water supply 8 Air conditioning 11 Injection well
 1 Domestic 3 Feedlot 6 Oil field water supply 9 Dewatering 12 Other (Specify below)
 2 Irrigation 4 Industrial 7 Domestic (lawn & garden) 10 Monitoring well
 Was a chemical/bacteriological sample submitted to Department? Yes _____ No If yes, mo/day/yr _____
 Sample was submitted _____ Water well disinfected? Yes No _____

5 TYPE OF CASING USED: 5 Wrought Iron 8 Concrete tile CASING JOINTS: Glued _____ Clamped _____
(1) Steel 3 RMP (SR) 6 Asbestos-Cement 9 Other (specify below) _____ Welded
 2 PVC 4 ABS 7 Fiberglass _____ Threaded _____

Blank casing diameter 12 in. to 133.81 ft., Diameter _____ in. to _____ ft., Diameter _____ in. to _____ ft.
 Casing height above land surface 12 in., weight 49.56 lbs./ft. Wall thickness or gauge No. 375

TYPE OF SCREEN OR PERFORATION MATERIAL:
 1 Steel **(3)** Stainless Steel 5 Fiberglass 7 PVC 9 ABS 11 Other (Specify) _____
 2 Brass 4 Galvanized Steel 6 Concrete tile 8 RM (SR) 10 Asbestos-Cement 12 None used (open hole)

SCREEN OR PERFORATION OPENINGS ARE:
(1) Continuous slot 3 Mill slot 5 Gauzed wrapped 7 Torch cut 9 Drilled holes 11 None (open hole)
 2 Louvered shutter 4 Key punched 6 Wire wrapped 8 Saw Cut 10 Other (Specify) _____

SCREEN-PERFORATED INTERVALS: From 133.81 ft. to 159.21 ft., From _____ ft. to _____ ft.
 From _____ ft. to _____ ft., From _____ ft. to _____ ft.
GRAVEL PACK INTERVALS: From 94 ft. to 147 ft., From _____ ft. to _____ ft.
 From 147 ft. to 159 ft., From _____ ft. to _____ ft.

6 GROUT MATERIAL: 1 Neat Cement **(2)** Cement grout 3 Bentonite **(4)** Other _____ Bentonite Holeplug
 Fill Sand
 Grout Intervals: From 25-74 ft. to _____ ft., From 0-25 ft. to _____ ft., From 74 ft. to 94 ft.
 What is the nearest source of possible contamination:
 1 Septic tank 4 Lateral lines 7 Pit privy 10 Livestock pens 13 Insecticide Storage **(16)** Other (specify below)
 2 Sewer lines 5 Cess pool 8 Sewage lagoon 11 Fuel storage 14 Abandoned water well _____
 3 Watertight sewer lines 6 Seepage pit 9 Feedyard 12 Fertilizer Storage 15 Oil well/gas well _____
 None known

Direction from well?			LITHOLOGIC LOG		PLUGGING INTERVALS	
FROM	TO		FROM	TO		
0	2	Topsoil				
2	8	Clay, reddish brown				
8	77	Clay, sandy, tan, with sand, very fine				
77	130	Sand, very fine, with clay streaks				
130	138	Sand, very fine, with lots of clay streaks, gray				
138	146	Sand, very fine				
146	155	Sand and gravel, fine, medium, coarse, with some clay				
155	158	Rocks and gravel, medium, coarse				
158	159	Shale, blue				

7 CONTRACTOR'S OR LANDOWNER'S CERTIFICATION: This water well was **(1) constructed** (2) reconstructed (3) plugged under my jurisdiction and was completed on (mo/day/year) 04-24-07 and this record is true to the best of my knowledge and belief.
 Kansas Water Well Contractor's License No. 185 This Water Well Record was completed on (mo/day/year) 05-02-07
 Under the business name of Clarke Well & Equipment, Inc. by (signature) _____

INSTRUCTIONS: Use typewriter or ball point pen. PLEASE PRESS FIRMLY and PRINT clearly. Please fill in blanks, underline or circle the correct answers. Send top three copies to Kansas Department of Health and Environment, Bureau of Water, Geology Section, 1000 SW Jackson St., Suite 420, Topeka, Kansas 66612-1367. Telephone 785-296-5522. Send one to WATER WELL OWNER and retain one for your records. Fee of \$5.00 for each constructed well.