


1	LOCATION OF WATER WELL:	Fraction	Section Number	Township Number	Range Number
County:	Pottawatomie	SE 1/4 NE 1/4 NW 1/4	27	T 9 S	R 9 (E) W

Distance and direction from nearest town or city street address of well if located within city?
 Approximately 3 3/4 miles north and 1 mile east of St. George

2 WATER WELL OWNER: Pottawatomie County RWD #1
 RR#, St. Address, Box # P.O. Box 233 Board of Agriculture, Division of Water Resources
 City, State, ZIP Code Wamego, KS 66547 Application Number:

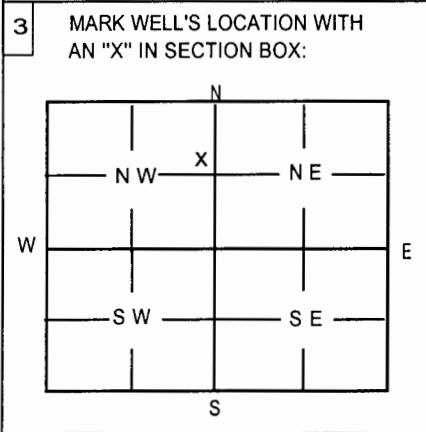

4 DEPTH OF WELL 124 ft
 WELL'S STATIC WATER LEVEL 65 ft.
 WELL WAS USED AS:
 1 Domestic 5 Public Water Supply 9 Dewatering
 2 Irrigation 6 Oil Field Water Supply **10 Monitoring Well**
 3 Feedlot 7 Domestic (Lawn & Garden) 11 Injection Well
 4 Industrial 8 Air Conditioning 12 Other
 Was a chemical / bacteriological sample submitted to Department? Yes No
 If yes, mo/day/yr sample was submitted
 Water Well Disinfected: Yes No

5 TYPE OF BLANK CASING USED:
 1 Steel 3 RMP (SR) 5 Wrought 7 Fiberglass 9 Other (Specify below)
2 PVC 4 ABS 6 Asbestos-Cement 8 Concrete Tile
 Blank casing diameter 5 in. Was casing pulled? Yes No
 Casing height above or **below** land surface 48 in. If yes, how much

6 GROUT PLUG MATERIAL: 1 Neat Cement 2 Cement grout 3 Bentonite **4 Other** Bentonite Holeplug
 Grout Plug Intervals: From ft. to ft., From ft. to ft. From 80 ft. to 4 ft.
 What is the nearest source of possible contamination:
 1 Septic tank 6 Seepage pit 11 Fuel storage **16 Other (specify below)**
 2 Sewer lines 7 Pit privy 12 Fertilizer storage
 3 Watertight sewer lines 8 Sewage lagoon 13 Insecticide storage None known
 4 Lateral lines 9 Feedyard 14 Abandoned water well
 5 Cess Pool 10 Livestock pens 15 Oil well/Gas well
 Direction from well? How many feet?

FROM	TO	PLUGGING MATERIALS
124	80	Chlorinated Sand
80	4	Bentonite Holeplug
4	0	Compacted Soil

7 CONTRACTOR'S OR LANDOWNER'S CERTIFICATION: This water well was plugged under my jurisdiction and was completed on (mo/day/year) 07-26-07 and this record is true to the best of my knowledge and belief. Kansas Water Well Contractor's License No. 185 This Water Well Record was completed on (mo/day/year) 07-30-07 under the business name of Clark Well & Equipment, Inc. by (signature) *David W. Clark*

INSTRUCTIONS: Use typewriter or ball point pen. Please press firmly and print clearly. Please fill in blanks, underline or circle the correct answers. Send top three copies to Kansas Department of Health & Environment, Bureau of Water, Topeka, Kansas 66620-0001. Telephone: 785/296-3565. Send one to Water Well Owner and retain one for your records.