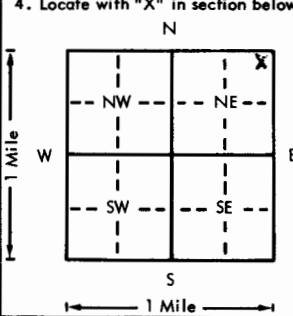
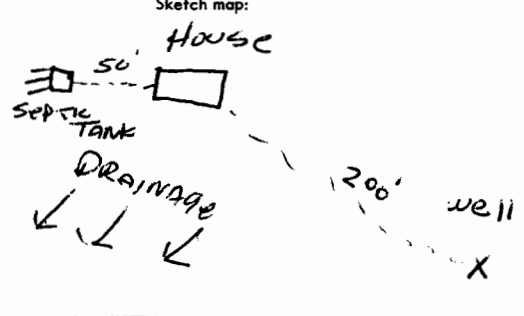


USE TYPEWRITER OR BALL POINT PEN—PRESS FIRMLY, PRINT CLEARLY.

WATER WELL RECORD
KSA 82a-1201-1215

Kansas Department of Health and Environment—Division of Environment (Water well Contractors)
Topeka, Kansas 66620

1. Location of well:		County ROT	Fraction NE 1/4 NE 1/4 NE 1/4	Section number 28	Township number T 9 S R 9 E/W	Range number	
2. Distance and direction from nearest town or city: 4 N Street address of well location if in city: OF ST. GEORGE			3. Owner of well: DOUG ZARGER City, state, zip code: MANHATTAN, KS. Box 100 66502				
4. Locate with "X" in section below: 			Sketch map: 			6. Bore hole dia. 10 in. Completion date _____ Well depth 100 ft. 3-25-76	
5. Type and color of material			From	To	7. Cable tool <input checked="" type="checkbox"/> Rotary <input type="checkbox"/> Driven <input type="checkbox"/> Dug <input type="checkbox"/> Hollow rod <input type="checkbox"/> Jetted <input type="checkbox"/> Bored <input type="checkbox"/> Reverse rotary		
					8. Use: <input checked="" type="checkbox"/> Domestic <input type="checkbox"/> Public supply <input type="checkbox"/> Industry <input type="checkbox"/> Irrigation <input type="checkbox"/> Air conditioning <input type="checkbox"/> Stock <input type="checkbox"/> Lawn <input type="checkbox"/> Oil field water <input type="checkbox"/> Other		
TOP SOIL			0	3	9. Casing: Material PVC Height: Above or below Threaded <input type="checkbox"/> Welded <input type="checkbox"/> Surface 24 in. RMP PVC 2 Weight 2.58 lbs./ft. Dia. 5 in. to 100 ft. depth Wall Thickness: inches or Dia. _____ in. to _____ ft. depth gauge No. 258		
BROWN CLAY			3	20	10. Screen: Manufacturer's name _____ PUMPCO Type PVC Dia. 5" Slot/gauze .025 Length 10 Set between 18 ft. and 28 ft. Gravel pack? <input checked="" type="checkbox"/> Size range of material 20X60		
GRAVEL			20	22	11. Static water level: _____ mo./day/yr. 20 ft. below land surface Date 3-25-76		
GREY LIME			22	58	12. Pumping level below land surfaces: AIR TEST _____ ft. after _____ hrs. pumping _____ g.p.m. _____ ft. after _____ hrs. pumping _____ g.p.m. Estimated maximum yield 5 AT 22' g.p.m.		
GREY SHALE			58	65	13. Water sample submitted: _____ mo./day/yr. <input type="checkbox"/> Yes <input checked="" type="checkbox"/> No Date _____		
GREY LIME			65	70	14. Well head completion: CAPPED <input type="checkbox"/> Pitless adapter 24 inches above grade		
GREY SHALE			70	100	15. Well grouted? <input checked="" type="checkbox"/> With: <input checked="" type="checkbox"/> Neat cement <input type="checkbox"/> Bentonite <input type="checkbox"/> Concrete Depth: From 0 ft. to 10 ft.		
					16. Nearest source of possible contamination: ft. 200 Direction NW Type SEPTIC TANK Well disinfected upon completion? <input checked="" type="checkbox"/> Yes <input type="checkbox"/> No		
					17. Pump: <input checked="" type="checkbox"/> Not installed Manufacturer's name _____ Model number _____ HP _____ Volts _____ Length of drop pipe _____ ft. capacity _____ g.p.m. Type: <input type="checkbox"/> Submersible <input type="checkbox"/> Turbine <input type="checkbox"/> Jet <input type="checkbox"/> Reciprocating <input type="checkbox"/> Centrifugal <input type="checkbox"/> Other		
(Use a second sheet if needed)					20. Water well contractor's certification: This well was drilled under my jurisdiction and this report is true to the best of my knowledge and belief. STRADER DRUG CO INC 182 Business name _____ License No. _____ Address RTI HOLTON, KS Signed Dale Andrew Date 3-26-76 Authorized representative		
18. Elevation:		19. Remarks: OWNER WILL INSTALL SLAB				20. Water well contractor's certification:	
Topography: <input type="checkbox"/> Hill <input type="checkbox"/> Slope <input type="checkbox"/> Upland <input checked="" type="checkbox"/> Valley							

Forward the white, blue and pink copies to the Department of Health and Environment

Form WWC-5