

USE TYPEWRITER OR BALL POINT PEN-PRESS FIRMLY, PRINT CLEARLY.


WATER WELL RECORD
KSA 82a-1201-1215

T R EW sec 1/4 1/4 1/4 No.

Kansas State Dept. Of Health
(Water Well Contractors)
Forbes-Bldg. 740
Topeka, Kansas 66620

1 Location of well: County Pottawatomie Township name St. George Fraction SW 1/4, SE 1/4 Section number 29 Town number T9S Range number R9E

Distance and direction from nearest town or city: 2 3/4 mi. N. of St. George, Ks.
Street address of well location if in city: _____
3 Owner of well: Rural Water District No. 1 Pottawatomie Co, Ks.
Address: 1008 Pine Wamego, Ks 66547

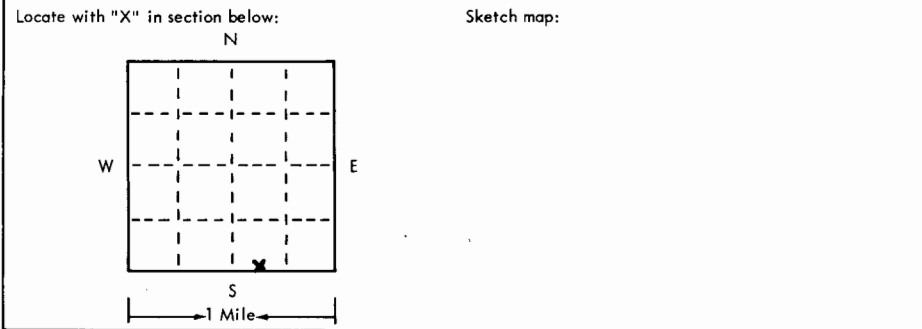

4 Well depth: 173 ft. Date of completion 1-27-75
Well diameter 22 in.
5 Cable tool Rotary Driven Dug
 Hollow rod Jetted Bored Reverse rotary
6 Use: Domestic Public supply Industry
 Irrigation Air conditioning Commercial
 Test well _____
7 Casing: Material Steel Height: above/~~below~~
Threaded Welded Surface 30 in.
Diam. _____ Weight 34.24 lbs./ft.
10 in. to 158 ft. depth Drive shoe? Yes No
_____ in. to _____ ft. depth

2	Type and color of material	From	To
	Top Soil	0	2
	Brown Clay	2	8
	Red Clay	8	20
	Fine Sand	20	65
	Clay	65	97
	Fine Sand	97	110
	Clay	110	132
	Fine Sand w/ Clay	132	145
	Fine to Coarse Sand w/ some Clay	145	153
	Coarse Sand & Gravel w/ Rocks	153	173
	Sandy Clay	173	176
	Gravel & Rocks	176	177
	Blue Shale	177	178
	(use a second sheet if needed)		

8 Screen: Manufacturer Cook
Type Wire Wrap Dia. 10"
Slot/gauze 70 Length 15'
Set between 158 ft. and 173 ft.
Fittings: Gravel pack Yes No Size range of material _____
9 Static water level: 83.5 ft. below land surface Date 2-12-75
10 Pumping level below land surfaces:
104.4 ft. after 24 hrs. pumping 250 g.p.m.
_____ ft. after _____ hrs. pumping _____ g.p.m.
Estimated maximum yield 300 g.p.m.
11 Water sample submitted:
 Yes No Date _____
12 Well head completion:
 Pitless adapter Inches above grade
13 Well grouted? Yes No
 Neat cement Bentonite _____
Depth: From 0 ft. to 20 ft.
14 Nearest source of possible contamination:
ft. _____ Direction _____ Type _____
Well disinfected upon completion? Yes No
15 Pump: Not installed
Manufacturer's name Jacuzzi
Model number SMS HP 20 Volts 480
Length of drop pipe 130 ft. capacity 250 g.m.p.
Type:
 Submersible Turbine
 Jet Reciprocating
 Centrifugal Other

16 Remarks: elevation West Well - "A"
1185
Topography:
 Hill
 Slope
 Upland
 Valley

17 Water well contractor's certification:
This well was drilled under my jurisdiction and this report is true to the best of my knowledge and belief.
Layne Western Co. 102
Business name _____ License No. _____
Address Wichita Kansas
Signed [Signature] Date 2/25/75
Authorized representative