USE TYPEWRITER OR BALL. POINT PEN-PRESS FIRMLY, PRINT CLEARLY.

WATER WELL RECORD
KSA 82a-1201-1215

Kansas Department of Health and Environment-Division of Environment
(Water well Contractors)
Topeka, Kansas 66620

1. Location of well:	County	Fraction	Section number	Township number	Range number
	Pottowatomie	SW 1/4 NE 1/4 NE 1/4	31	T 9 South S	R 9 east E/W

2. Distance and direction from nearest town or city: 4 1/2 mi South of Flush and 1/4 mi Southwest
Street address of well location if in city:

3. Owner of well: Delbert Ubel
R.R. or street: R5
City, state, zip code: Manhattan Kans

4. Locate with "X" in section below:

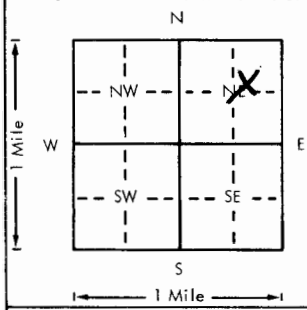

Sketch map:

6. Bore hole dia. 10 in. Completion date
Well depth 125 ft. 6-12-79

7. __ Cable tool X Rotary __ Driven __ Dug
__ Hollow rod __ Jetted __ Bored __ Reverse rotary

8. Use: X Domestic __ Public supply __ Industry
__ Irrigation __ Air conditioning __ Stock
__ Lawn __ Oil field water __ Other

9. Casing: Material PVC Height: Above or below
Threaded ____ Welded ____ Surface 12 in.
RMP ____ PVC ____ Weight ____ lbs./ft.
Dia. 5 in. to 125 ft. depth Wall Thickness or Gage No. .267 Wall
Dia. ____ in. to ____ ft. depth

5. Type and color of material

	From	To
top soil	0	2
Clay, Red + Brown	2	12
Sand, Very fine	12	15
Clay, tan	15	19
Very fine Sand	19	32
Clay, tan	32	39
Sand + Clay	39	70
Sand, fine	70	74
Clay tan	74	91
Sand, Very fine	91	98
Clay, Blue	98	107
Rock, loose (Water)	107	114
Shale, Blue	114	125

(Use a second sheet if needed)

10. Screen: Manufacturer's name Cay Ten by Lowery
Type PVC Dia. 5"
Slot/~~gauge~~ 030 Length 20'
Set between 105 ft. and 125 ft.
____ ft. and ____ ft.
Gravel pack? X Size range of material 1/16 X 1/8

11. Static water level: mo./day/yr.
83 ft. below land surface Date 6-12-79

12. Pumping level below land surfaces:
____ ft. after ____ hrs. pumping ____ g.p.m.
____ ft. after ____ hrs. pumping ____ g.p.m.
Estimated maximum yield 10 g.p.m.

13. Water sample submitted: mo./day/yr.
__ Yes X No Date

14. Well head completion: NA
__ Pitless adapter ____ Inches above grade

15. Well grouted? X
With: __ Neat cement X Bentonite __ Concrete
Depth: From 15 ft. to 5 ft.

16. Nearest source of possible contamination:
ft. 250 Direction east Type ditch
Well disinfected upon completion? X Yes __ No

17. Pump: X Not installed
Manufacturer's name
Model number ____ HP ____ Volts ____
Length of drop pipe ____ ft. capacity ____ g.p.m.
Type:
__ Submersible __ Turbine
__ Jet __ Reciprocating
__ Centrifugal __ Other

T 9 R 9 E/W Sec 31 1/4 SW 1/4 1/4 NE 1/4

18. Elevation:

Topography:
__ Hill
__ Slope
X Upland
__ Valley

19. Remarks:

20. Water well contractor's certification:
This well was drilled under my jurisdiction and this report is true to the best of my knowledge and belief.
Business name Strader Drilling Co. License No. 237
Address Blue Rapids
Signed Harold Strader Date 6-17-79
Authorized representative

Forward the white, blue and pink copies to the Department of Health and Environment

Form WWC-5