


1 LOCATION OF WATER WELL: Fraction NE 1/4 NE 1/4 NE 1/4 Section Number 35 Township Number T 9 S Range Number R 9 E/W
 County: Pottawatomie

Distance and direction from nearest town or city street address of well if located within city?
From Wamego 60 North 1/2 on 99 to Elm Slough + 5 miles west

2 WATER WELL OWNER: DEAN MAGNETT
 RR#, St. Address, Box #: LOT 89 WALNUT GROVE
 City, State, ZIP Code: St George 66535
 Board of Agriculture, Division of Water Resources
 Application Number:

3 LOCATE WELL'S LOCATION WITH AN "X" IN SECTION BOX:

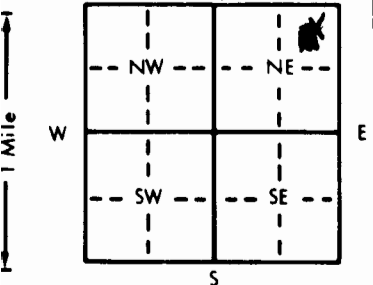

4 DEPTH OF COMPLETED WELL: 126 ft. ELEVATION:
 Depth(s) Groundwater Encountered 1. 55' ft. 2. ft. 3. ft.
 WELL'S STATIC WATER LEVEL 55' ft. below land surface measured on mo/day/yr
 Pump test data: Well water was ft. after hours pumping gpm
 Est. Yield 50 gpm: Well water was ft. after hours pumping gpm
 Bore Hole Diameter 10 in. to 12.6 ft., and in. to ft.
 WELL WATER TO BE USED AS:
 1 Domestic 3 Feedlot 6 Oil field water supply 9 Dewatering 12 Other (Specify below)
 2 Irrigation 4 Industrial 7 Lawn and garden only 10 Monitoring well
 Was a chemical/bacteriological sample submitted to Department? Yes No X; If yes, mo/day/yr sample was submitted
 Water Well Disinfected? Yes No

5 TYPE OF BLANK CASING USED:
 1 Steel 3 RMP (SR) 6 Asbestos-Cement 9 Other (specify below)
 2 PVC 4 ABS 7 Fiberglass
 CASING JOINTS: Glued Stamped Welded Threaded

Blank casing diameter 5 in. to 10.6 ft., Dia in. to ft., Dia in. to ft.
 Casing height above land surface 24" in., weight 30.40 lbs./ft. Wall thickness or gauge No.

TYPE OF SCREEN OR PERFORATION MATERIAL:
 1 Steel 3 Stainless steel 5 Fiberglass 7 PVC 10 Asbestos-cement
 2 Brass 4 Galvanized steel 6 Concrete tile 8 RMP (SR) 11 Other (specify)
 12 None used (open hole)

SCREEN OR PERFORATION OPENINGS ARE:
 1 Continuous slot 3 Mill slot 16/1000 6 Wire wrapped 9 Drilled holes
 2 Louvered shutter 4 Key punched 7 Torch cut 10 Other (specify)
 8 Saw cut 11 None (open hole)

SCREEN-PERFORATED INTERVALS: From 10.6 ft. to 12.6 ft., From ft. to ft.
 From ft. to ft., From ft. to ft.
 GRAVEL PACK INTERVALS: From 20 ft. to 12.6 ft., From ft. to ft.
 From ft. to ft., From ft. to ft.

6 GROUT MATERIAL: 1 Neat cement 2 Cement grout 3 Bentonite Eutomplug 4 Other
 Grout Intervals: From 0 ft. to 20 ft., From ft. to ft., From ft. to ft.

What is the nearest source of possible contamination:
 1 Septic tank 4 Lateral lines 7 Pit privy 10 Livestock pens 14 Abandoned water well
 2 Sewer lines 5 Cess pool 8 Sewage lagoon 11 Fuel storage 15 Oil well/Gas well
 3 Watertight sewer lines 6 Seepage pit 9 Feedyard 12 Fertilizer storage 16 Other (specify below)
 13 Insecticide storage

Direction from well? EAST How many feet? 600'

FROM	TO	LITHOLOGIC LOG	FROM	TO	PLUGGING INTERVALS
0	35	SANDY CLAY			
35	100	FINE SAND			
100	103	MED SAND			
123	126	GRAY SHALE			

7 CONTRACTOR'S OR LANDOWNER'S CERTIFICATION: This water well was (1) constructed, (2) reconstructed, or (3) plugged under my jurisdiction and was completed on (mo/day/year) 9/26/89 and this record is true to the best of my knowledge and belief, Kansas Water Well Contractor's License No. 450 This Water Well Record was completed on (mo/day/yr) 9/28/89 under the business name of Haldeman Well Drilling by (signature) [Signature]

OFFICE USE ONLY T R EW SEC 1/4 1/4 1/4