


1 LOCATION OF WATER WELL: Fraction  $\frac{1}{4}$   $\frac{1}{4}$  NE  $\frac{1}{4}$  Section Number 35 Township Number T 9 S Range Number R 9 E

Distance and direction from nearest town or city street address of well if located within city? From Manhattan Go East 11 miles on Highway 24 to Flint Rock Road then Go North 1 1/2 miles to Mill Creek

2 WATER WELL OWNER: MAXINE M. PFISTER  
 RR#, St. Address, Box #: 115 North 18th St.  
 City, State, ZIP Code: Manhattan, KS 66502  
 Board of Agriculture, Division of Water Resources  
 Application Number:

3 LOCATE WELL'S LOCATION WITH AN "X" IN SECTION BOX:

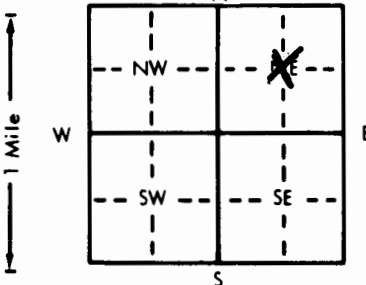

4 DEPTH OF COMPLETED WELL: 100' ft. ELEVATION:  
 Depth(s) Groundwater Encountered 1. 78 ft. 2. ft. 3. ft.  
 WELL'S STATIC WATER LEVEL: 78 ft. below land surface measured on mo/day/yr  
 Pump test data: Well water was ft. after hours pumping gpm  
 Est. Yield 15 gpm Well water was ft. after hours pumping gpm  
 Bore Hole Diameter: 10 in. to 140 ft., and in. to ft.  
 WELL WATER TO BE USED AS:  
 Domestic  3 Feedlot  6 Oil field water supply  9 Dewatering  12 Other (Specify below)  
 1 Irrigation  4 Industrial  7 Lawn and garden only  10 Monitoring well  
 Was a chemical/bacteriological sample submitted to Department? Yes No; If yes, mo/day/yr sample was submitted  
 Water Well Disinfected:  Yes  No

5 TYPE OF BLANK CASING USED:  
 1 Steel  3 RMP (SR)  6 Asbestos-Cement  9 Other (specify below)  
 2 PVC  4 ABS  7 Fiberglass  
 Blank casing diameter: 5 in. to 80 ft., Dia. in. to ft., Dia. in. to ft.  
 Casing height above land surface: 2 in., weight Sch. 40 lbs./ft. Wall thickness or gauge No.

TYPE OF SCREEN OR PERFORATION MATERIAL:  
 1 Steel  3 Stainless steel  5 Fiberglass  8 RMP (SR)  10 Asbestos-cement  
 2 Brass  4 Galvanized steel  6 Concrete tile  9 ABS  11 Other (specify)  
 12 None used (open hole)

SCREEN OR PERFORATION OPENINGS ARE:  
 1 Continuous slot  3 Mill slot 1600's  5 Gauzed wrapped  8 Saw cut  11 None (open hole)  
 2 Louvered shutter  4 Key punched  6 Wire wrapped  9 Drilled holes  10 Other (specify)  
 7 Torch cut

SCREEN-PERFORATED INTERVALS: From 80 ft. to 100 ft.  
 GRAVEL PACK INTERVALS: From 20 ft. to 100 ft.

6 GROUT MATERIAL:  1 Neat cement  2 Cement grout  3 Bentonite  4 Other  
 Grout Intervals: From 0 ft. to 20 ft., From ft. to ft.

What is the nearest source of possible contamination: None Close  
 1 Septic tank  4 Lateral lines  7 Pit privy  10 Livestock pens  14 Abandoned water well  
 2 Sewer lines  5 Cess pool  8 Sewage lagoon  11 Fuel storage  15 Oil well/Gas well  
 3 Watertight sewer lines  6 Seepage pit  9 Feedyard  12 Fertilizer storage  16 Other (specify below)  
 13 Insecticide storage

Direction from well? How many feet?

FROM	TO	LITHOLOGIC LOG	FROM	TO	PLUGGING INTERVALS
0	18	Brown Clay			
18	57	Sandy Clay			
57	78	Fine Sand			
78	140	Medium Sand (Water)			

7 CONTRACTOR'S OR LANDOWNER'S CERTIFICATION: This water well was (1) constructed, (2) reconstructed, or (3) plugged under my jurisdiction and was completed on (mo/day/year) 6/13/90 and this record is true to the best of my knowledge and belief. Kansas Water Well Contractor's License No. 459 This Water Well Record was completed on (mo/day/yr) 6/29/90 under the business name of Halderman Well Drilling by (signature) Craig CWD/PI