


1 LOCATION OF WATER WELL: County: POTT Fraction: NE 1/4 NE 1/4 NE 1/4 Section Number: 35 Township Number: T 9 S Range Number: R 9 EW

Distance and direction from nearest town or city street address of well if located within city? From Wamigo Co 2 miles West on 24<sup>th</sup> Hwy Co 1 1/2 miles North & 100' West

2 WATER WELL OWNER: MAXINE PHISTE  
 RR#, St. Address, Box #: RR Board of Agriculture, Division of Water Resources  
 City, State, ZIP Code: Wamigo, KS 66547 Application Number:

3 LOCATE WELL'S LOCATION WITH AN "X" IN SECTION BOX:

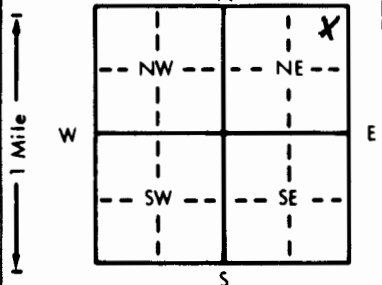

4 DEPTH OF COMPLETED WELL: 120 ft. ELEVATION:

Depth(s) Groundwater Encountered 1. 7.5 ft. 2. ft. 3. ft.  
 WELL'S STATIC WATER LEVEL: 7.5 ft. below land surface measured on mo/day/yr

Pump test data: Well water was ft. after hours pumping gpm  
 Est. Yield: 2.0 gpm; Well water was ft. after hours pumping gpm  
 Bore Hole Diameter: 10 in. to 120 ft., and in. to ft.

WELL WATER TO BE USED AS:  
 1 Domestic  3 Feedlot  6 Oil field water supply  9 Dewatering  12 Other (Specify below)  
 2 Irrigation  4 Industrial  7 Lawn and garden only  10 Monitoring well

Was a chemical/bacteriological sample submitted to Department? Yes No; If yes, mo/day/yr sample was submitted  
 Water Well Disinfected?  Yes  No

5 TYPE OF BLANK CASING USED: 5 Wrought iron 8 Concrete tile CASING JOINTS:  Glued  Clamped

Blank casing diameter: 5 in. to 100 ft., Dia. in. to ft., Dia. in. to ft.  
 Casing height above land surface: 2 in., weight 56.40 lbs./ft. Wall thickness or gauge No.

TYPE OF SCREEN OR PERFORATION MATERIAL:  
 1 Steel  3 Stainless steel  5 Fiberglass  8 RMP (SR)  11 Other (specify)  
 2 Brass  4 Galvanized steel  6 Concrete tile  9 ABS  12 None used (open hole)

SCREEN OR PERFORATION OPENINGS ARE:  
 1 Continuous slot  3 Mill slot 10 R005  5 Gauzed wrapped  8 Saw cut  11 None (open hole)  
 2 Louvered shutter  4 Key punched  6 Wire wrapped  9 Drilled holes  
 7 Torch cut  10 Other (specify)

SCREEN-PERFORATED INTERVALS: From 100 ft. to 120 ft., From ft. to ft.  
 GRAVEL PACK INTERVALS: From 25 ft. to 120 ft., From ft. to ft.

6 GROUT MATERIAL: 1 Neat cement 2 Cement grout  3 Bentonite 4 Other

Grout Intervals: From 0 ft. to 25 ft., From ft. to ft., From ft. to ft.  
 What is the nearest source of possible contamination: NOM CLOST  
 1 Septic tank  4 Lateral lines  7 Pit privy  10 Livestock pens  14 Abandoned water well  
 2 Sewer lines  5 Cess pool  8 Sewage lagoon  11 Fuel storage  15 Oil well/Gas well  
 3 Watertight sewer lines  6 Seepage pit  9 Feedyard  12 Fertilizer storage  16 Other (specify below)  
 13 Insecticide storage

Direction from well? How many feet?

FROM	TO	LITHOLOGIC LOG	FROM	TO	PLUGGING INTERVALS
0	1	Top Soil			
1	6	Brown Clay			
6	7.5	Sandy Clay			
7.5	120	Fine Sand (WATER)			

7 CONTRACTOR'S OR LANDOWNER'S CERTIFICATION: This water well was  (1) constructed,  (2) reconstructed, or  (3) plugged under my jurisdiction and was completed on (mo/day/year) 9/17/92 and this record is true to the best of my knowledge and belief. Kansas Water Well Contractor's License No. 451 This Water Well Record was completed on (mo/day/yr) 10/11/92 under the business name of Halderman Well Drilling by (signature) Craig Halderman CWD